A SURVEY FOR DOUGCO CREDIT UNION IN BLOCK 22 OF RIVERSIDE ADDITION, N/E 1/4 OF SEC. 13 T27S, R6W, W.M., DOUGLAS COUNTY, OREGON

COUNTY SURVEYORS FILE DATA
DO NOT REMOVE FROM OFFICE

FILED TF
OCT 22 1987
COUNTY SURVEYOR
DOUGLAS COUNTY, ORE.

NARRATIVE: FOUND MONUMENTS PER M31-22 & C.S.55/93

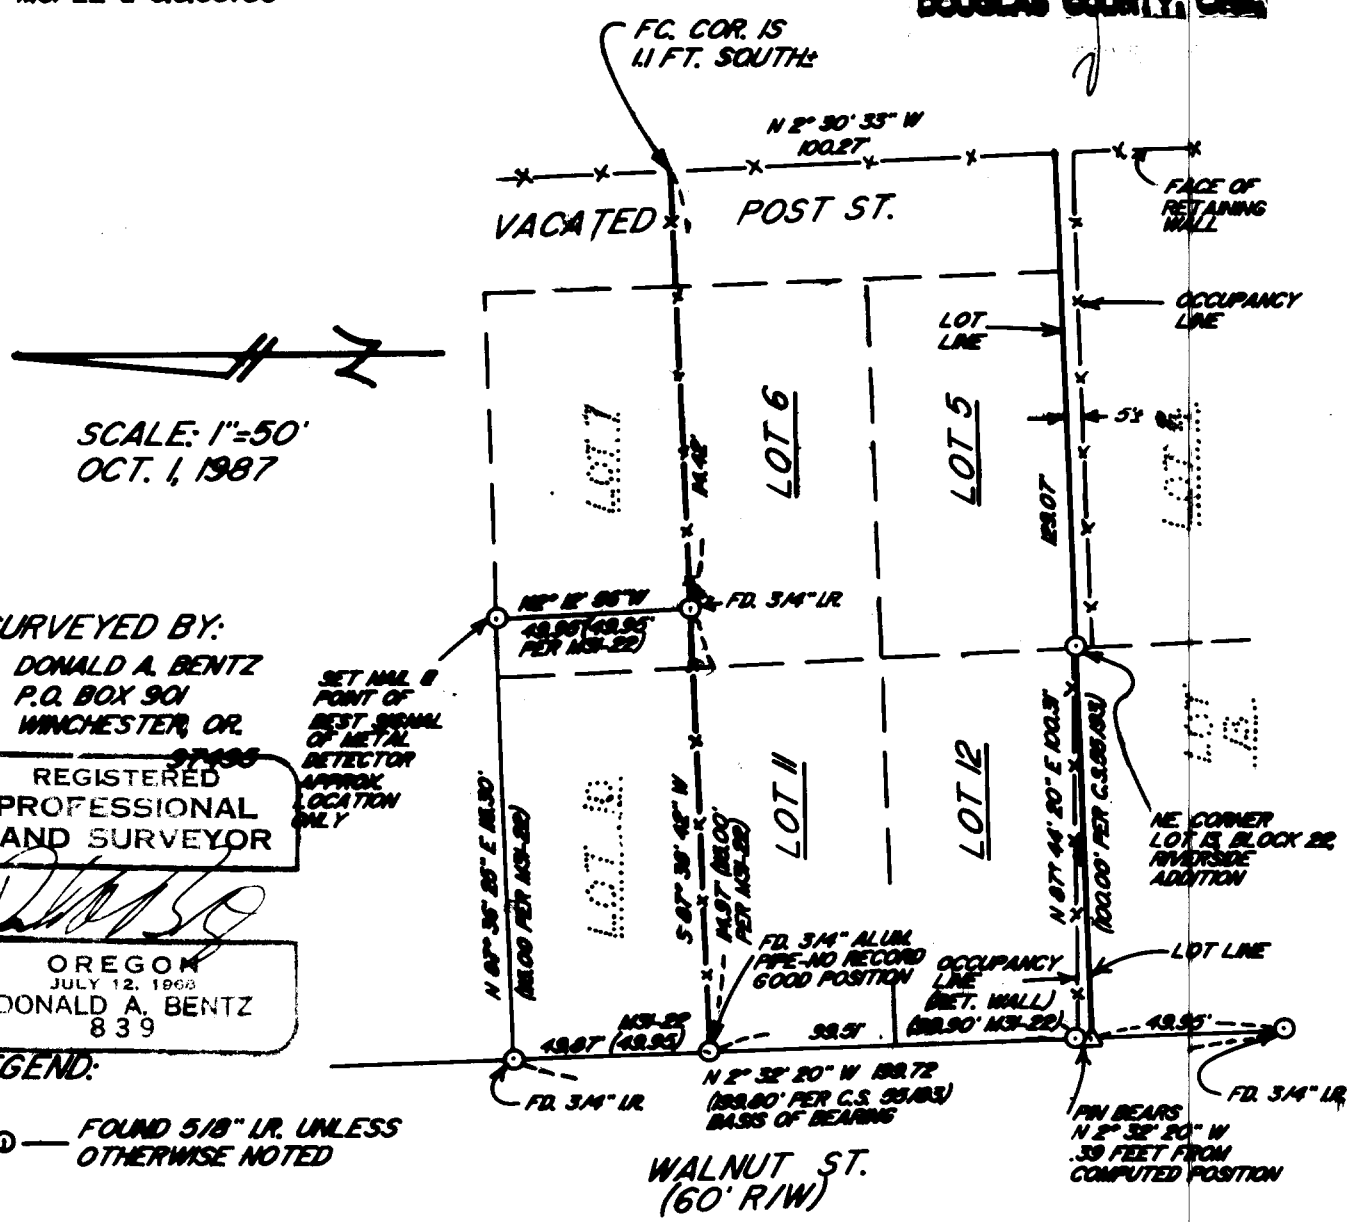

SCALE: 1"=50'
OCT. 1, 1987

SURVEYED BY:
DONALD A. BENTZ
P.O. BOX 901
WINCHESTER, OR.
97495

REGISTERED PROFESSIONAL LAND SURVEYOR
OREGON
JULY 12, 1968
DONALD A. BENTZ
839

LEGEND:

① — FOUND 5/8" I.R. UNLESS OTHERWISE NOTED

C.S. File No. 63/42-2