

CORNER RENEWAL  
INTERNATIONAL PAPER COMPANY ENGINEER CREW

CORNER SW SEC. 2, T 23 S, R 9 W, Will. Mer.

FILED

*[Signature]*

MAY 12 1987

COUNTY SURVEYOR  
DOUGLAS COUNTY, ORE.

RECORD	FOUND	SET
1969 Douglas County brass cap on 2" I.P.	1969 Douglas County B.C./I.P. buried 60" deep in road sidecast	2" brass cmp marked: "T23S - R9W 10 1/2" LS 1667", on 36" x 1 1/4" I.P. 60" above Doug.Co.B.C.
22" OBT Maple N89E 44 LKS	Road sidecast buried any evidence.	-
12" Maple BT(THIEL) S89 1/2 W 30 LKS	No evidence found	-
13" Maple BT(THIEL) N75W 24 LKS	Root was dug out and rolled down slope during road construction.	-
12" Hemlock BT(Doug.Co.1969) S88E, 12 LKS	Destroyed during logging	-
18" Fir BT(Doug.Co. 1969) S25W, 33 LKS	Root was rolled down hill during road construction	-
9" Hemlock BT(Doug.Co. 1969) N31W, 67 LKS	8" Hemlock stump, face visible, 2 Doug. Co. tags N31W, 44.6 ft.	-
		"X" marked on 24" Douglas fir bears S78 1/2 W, 73.1 ft. to nail in tree, IPCo. tag
		54" Douglas fir stump with IPCo. tag bears S36E, 46.4 ft.

MONUMENT

ACCESSORIES

Date: 5-8-87


INTERNATIONAL PAPER CO.  
P. O. Box 43  
Gardiner, Or 97441  
Phone: 503-271-3688

REGISTERED  
PROFESSIONAL  
LAND SURVEYOR

*W. Carey Weatherly*  
OREGON  
July 14, 1978  
W. CAREY WEATHERLY  
1667

C.S. File No. 63/55-4

# 96 X

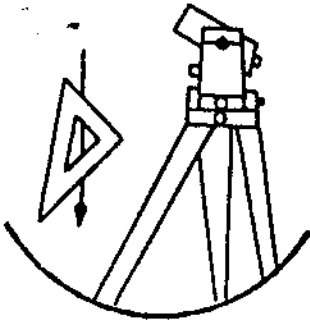

FRITZ INGRAM  
COUNTY SURVEYOR

## DOUGLAS COUNTY SURVEYOR'S OFFICE

ROOM 206 - JUSTICE BUILDING  
ROSEBURG, OREGON 97470  
PHONE 440-4272

ED,

PLEASE FILE THIS CORNER RENEWAL.  
THERE IS NO SURVEY. WE REHAB'ED  
THE CORNER BECAUSE WE BURIED IT  
DURING ROAD CONSTRUCTION AND  
LOGGING. I THEN PROCRASTINATED.

April 30, 1987

W. Carey Weatherly  
28251 Oregon State Hwy. 38  
Elkton, OR 97436

CAREY

RE: T23S R9W S3|S2  
S10|S11

Dear Carey:

During a recent corner restoration, our crew located a brass cap monument at the noted location. The cap has LS Registration Number 1667 and is dated 1986. Since the monument has been set at least 5 months and we have no record of it, I decided to check with you. You probably have a survey in progress and intent to file soon, or sometimes people just forget. We would appreciate knowing if your map will be filed soon.

Sincerely,

Larry "Ed" Monrean  
Survey Supervisor