FILED TF

JUL 5 1988 F

COUNTY SURVEYOR
DOUGLAS COUNTY, ORE.

REGISTERED
PROFESSIONAL
AND SURVEYOR

OREGON
JULY 10, 1979
DONALD A. BENTZ
939

A SURVEY IN LOT 5 OF RIDGEVIEW ESTATES

ALL LYING IN THE EAST 1/2 OF SEC 2, T27S, R6W, W.M.

COUNTY SURVEYORS FILE DATA
DO NOT REMOVE FROM OFFICE

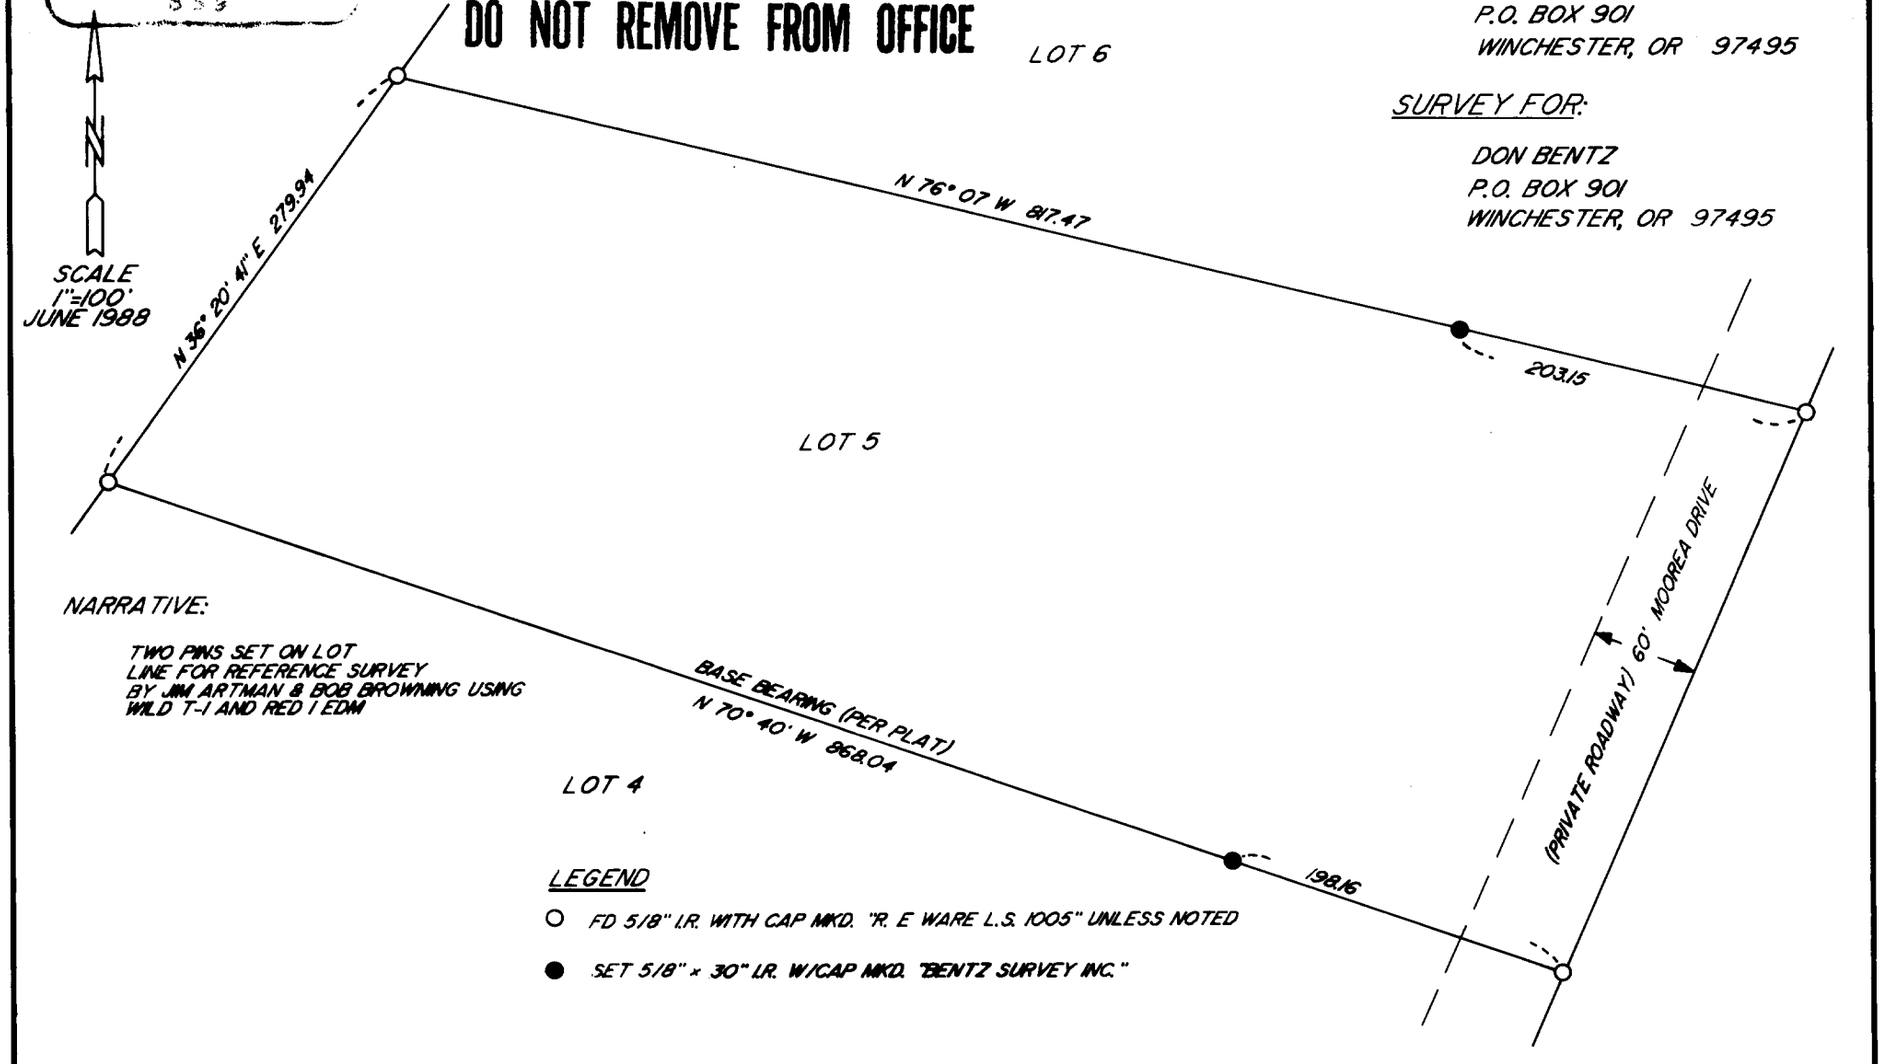

SURVEY BY:

DONALD A. BENTZ INC.
P.O. BOX 901
WINCHESTER, OR 97495

SURVEY FOR:

DON BENTZ
P.O. BOX 901
WINCHESTER, OR 97495

NARRATIVE:

TWO PINS SET ON LOT LINE FOR REFERENCE SURVEY BY JIM ARTMAN & BOB BROWNING USING WILD T-1 AND RED 1 EDM

LEGEND

○ FD 5/8" I.R. WITH CAP MKD. "R. E WARE L.S. 1005" UNLESS NOTED

● SET 5/8" x 30" I.R. W/CAP MKD. "BENTZ SURVEY INC."

U.S. File No. 63/76-1