SURVEY IN SEC. 18., T. 25S., R. 4 W., W.M.
DOUGLAS CO., ORE. SCALE 1" = 300' AUG 1988
FOR HUBERT SIGL P.O. Box 576 OAKLAND, ORE.

FILED
SEP 13 1988
COUNTY SURVEYOR
DOUGLAS COUNTY, ORE

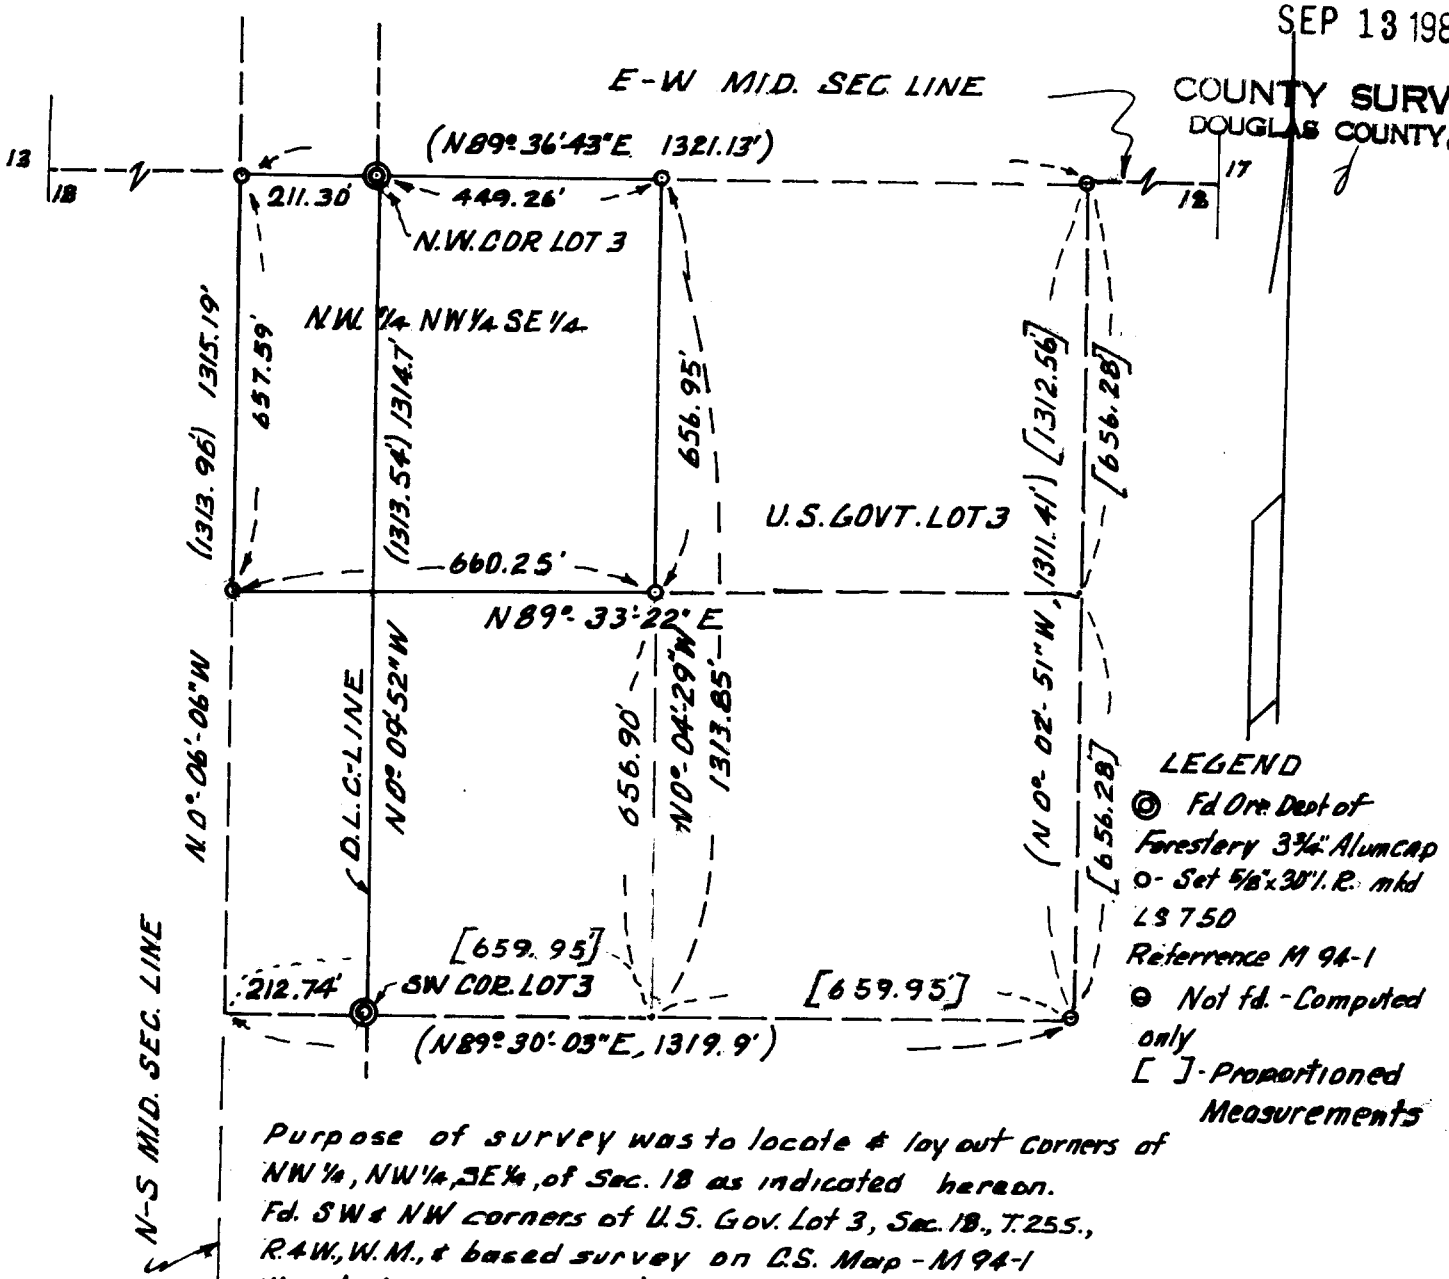

LEGEND
◎ Fd Ore. Dept of Forestery 3¼" Alum Cap
o - Set 5/8"x30" I.R. mkd LS 750
Referrence M 94-1
⊙ Not fd. - Computed only
[ ] - Proportioned Measurements

Purpose of survey was to locate & lay out corners of NW¼, NW¼ SE¼, of Sec. 18 as indicated hereon. Fd. SW & NW corners of U.S. Gov. Lot 3, Sec. 18., T. 25S., R. 4W., W.M., & based survey on C.S. Map - M 94-1
Used Jena 010 & Mack II H.L. Northcraft π
Tyler Northcraft ch

Survey by Herbert L. Northcraft
3520 OLALLA Rd.,
Winston, Oregon

REGISTERED
PROFESSIONAL
LAND SURVEYOR
Herbert L. Northcraft

OREGON
JULY 6, 1966
HERBERT L. NORTHCRAFT
750

COUNTY SURVEYORS FILE DATA
DO NOT REMOVE FROM OFFICE

C.S. File No. 63/79-2