FILED

JAN 6 1989

COUNTY SURVEYOR
DOUGLAS COUNTY, ORE.

OREGON CORNER RESTORATION FORM

Section 34 Township 20S Range 9W

County Douglas Date 10-31-88

CORNER DESIGNATION

N.W. Corner
Section 34

28	27
33	34

___ Condition Report Only
___ Not Found
___ Renewed
___ Unrecorded
___ Surveyed In
x Referenced Out

Previous Renewals/Surveys, etc. A Thomas A. Tillman and Joseph S. Gawron G.L.O. Survey dated 1953-1954.

Monument(s) & Accessories Found: (Condition and Source)

Found 1953 G.L.O. Brass Cap set firmly in the ground.
16" Fir, N14E, 20.0' (Scar Vis.), 1953 BT. Rec. N13½E, 19.8'
18" Fir, S51W, 24.3' (Scar Vis.), 1953 BT. Rec. S56¼W, 25.7'
24" Fir, N52W, 18.0' (Scar Vis.), 1953 BT. Rec. N51 3/4W, 17.8'
28" Fir, S08E, 1.7' (Scar Vis.), 1953 BT. Rec. S10E, 2.3'

Monument Detail

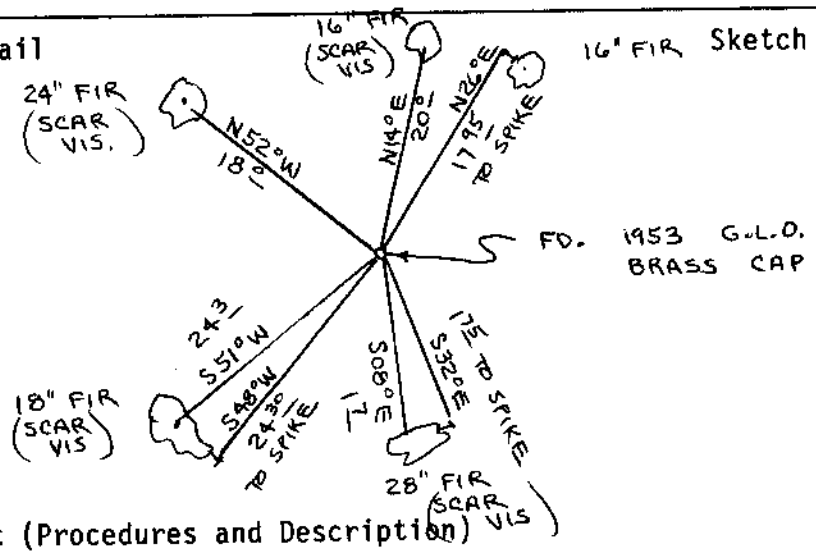

16" FIR Sketch

Monument Set (Procedures and Description)

New Accessories

Because of planned logging activity in this area in the near future, I set the following R.P.'s.
16" Fir, N26E, 17.95' to 6" steel spike.
18" Fir, S48W, 24.30' to 6" steel spike.
28" Fir, S32E, 1.75' to 6" steel spike.

Location & Comments

Compass Declination 20½

Firm/Agency Roberts Surveying Inc.

Address 29 West 29th St. Eugene, Oregon 97405

Party Chief Les Roberts

Notes Ted Baker

Witness

Surveyor's Seal

REGISTERED PROFESSIONAL LAND SURVEYOR
Les Roberts
OREGON
AUGUST 22, 1975
L. D. ROBERTS
1039

#674

C.S. File No. 63/85-10