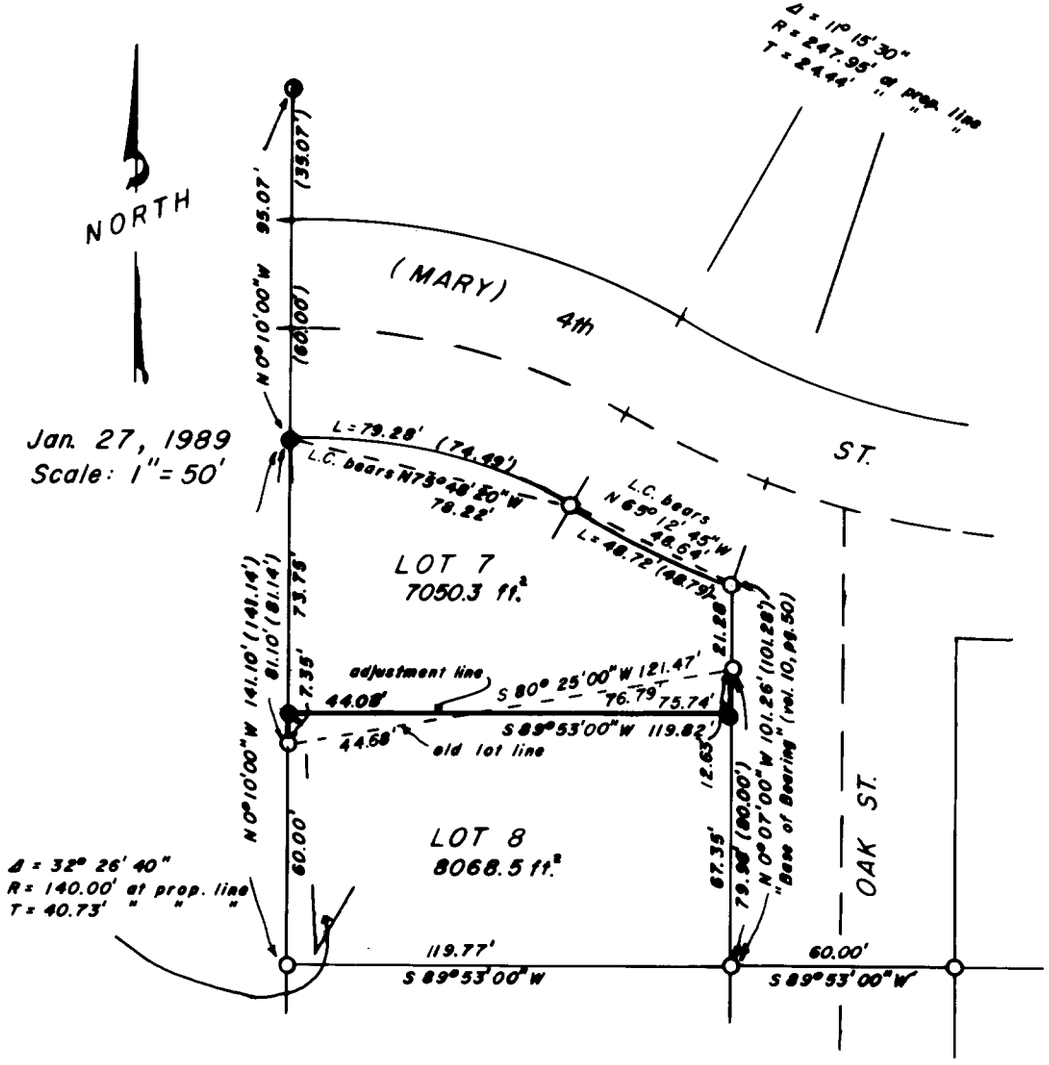

LEGEND

- ○ Fd. 3/4" iron rod as per Vol. 10, Pg 50
- ◑ Fd. 2" iron pipe as per Vol. 10, Pg 50
- ● Set 3/4" x 30" iron pipe, Mkd. L S 1261 on top side
- ( ) Record as per Vol. 10, Pg 50

LOT LINE ADJUSTMENT SURVEY

FILED
MAR 1 1989 TF
COUNTY SURVEYOR
DOUGLAS COUNTY, ORE.
TF

COUNTY SURVEYORS FILE DATA
DO NOT REMOVE FROM OFFICE

Located in the North 1/2, Section 24,
Township 30 South, Range 6 West,
Willamette Meridian, Doug. Co., OR.
City of Riddle

Prepared for Willard Boyd
P. O. Box 540
Riddle, OR. 97469

Showing Lot line adjustment between Lot 7 and 8, Twin Oaks "TRACT A", City of Riddle

NARRATIVE: The purpose of the survey was to establish an adjusted lot line between Lot 7 and 8, Twin Oaks "Tract A". The said found lot corners controlled the survey, with the bearings of the lot lines agreeing with that of the original subdivision. An error was found in the original subdivision in the most northerly lot line of Lot 7 and was adjusted to close the traverse by re-establishing the most northwesterly corner of said Lot 7. The Easterly side of Lot 7 and 8 showed said found iron rods and was used as "Base of Bearing".

JOHN H. MARKHAM JR.
P.O. BOX 802
MYRTLE CREEK, OR. 97457
ph. 863-4590

DRAWN BY: RAYMOND BROWN
ph. 839-6185

REGISTERED
PROFESSIONAL
LAND SURVEYOR
John H. Markham Jr.
OREGON
SEPTEMBER 23, 1977
JOHN H. MARKHAM, JR.
1261

C.S. File No. 63/89