M109-74 A&B

(5)

FILED

APR 9 1990

COUNTY SURVEYOR
DOUGLAS COUNTY, ORE.

OREGON CORNER RESTORATION FORM

Section 11 Township 22S Range R6W

County DOUGLAS Date 3/23/90

Corner Designation

CENTER 1/4, CENTER OF SECTION 11

___ Condition Report Only
___ Not Found
___ Renewed
___ Unrecorded
X Surveyed In
___ Referenced Out

Previous Renewals/Surveys, etc. _____

Monument(s) & Accessories Found: (Condition and Source)

EXISTING NORTH-SOUTH FENCE LINE IS WEST 18.5 FEET MORE OR LESS OF THE CORNER SET.

Monument Detail BT#1 15" D. FIR

Sketch

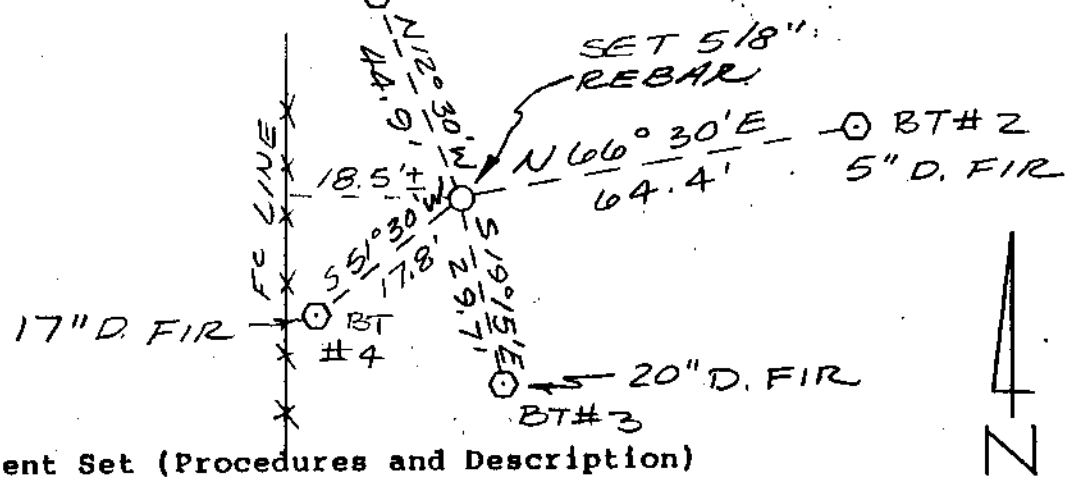

Monument Set (Procedures and Description)

SET 5/8" X 30" REBAR WITH YELLOW PLASTIC CAP MARKED "BRANCH ENG LS 1138". CORNER WAS SET AT THE STRAIGHT LINE INTERSECTION POINT BETWEEN THE NORTH AND SOUTH QUARTER CORNERS AND THE EAST AND WEST QUARTER CORNERS.

New Accessories

1) 15" D. FIR SCRIBED "C 1/4 S11 BT" BEARS N 12° 30' W 44.9'
2) 5" D. FIR SCRIBED "C 1/4 S11 BT" BEARS N 66° 30' E 64.4'
3) 20" D. FIR SCRIBED "C 1/4 S11 BT" BEARS S 19° 15' E 29.7'
4) 17" D. FIR SCRIBED "C 1/4 S11 BT" BEARS S 51° 30' W 17.8'

Location & Comments

Surveyor's Seal

REGISTERED PROFESSIONAL LAND SURVEYOR

OREGON SEPT. 23, 1977 JAMES A. BRANCH 1138

Compass Declination ____

Firm/Agency BRANCH ENGINEERING

Address 212 Q STREET SPRINGFIELD, OR

Party Chief R. OLSON

Notes ____

Witness G. HOFFMAN

#163 X

C.S. File No. L3/104-11 C