COUNTY SURVEYORS FILE DATA
DO NOT REMOVE FROM OFFICE

FIELD SURVEY & PLAT FOR
DONALD F. MADDUX
MYRTLE CREEK, OREGON

PART OF LOT 25 "SCHMOLL PLAT A"
NW¼ SE¼ SEC. 7 T30S R5W W.M. DOUGLAS COUNTY ORE.

SCALE: 1" = 60'

MARTIN ENGINEERING SERVICE ~ MYRTLE CREEK, OREGON

FILED
JUN 20 1990
COUNTY SURVEYOR
DOUGLAS COUNTY, ORE.

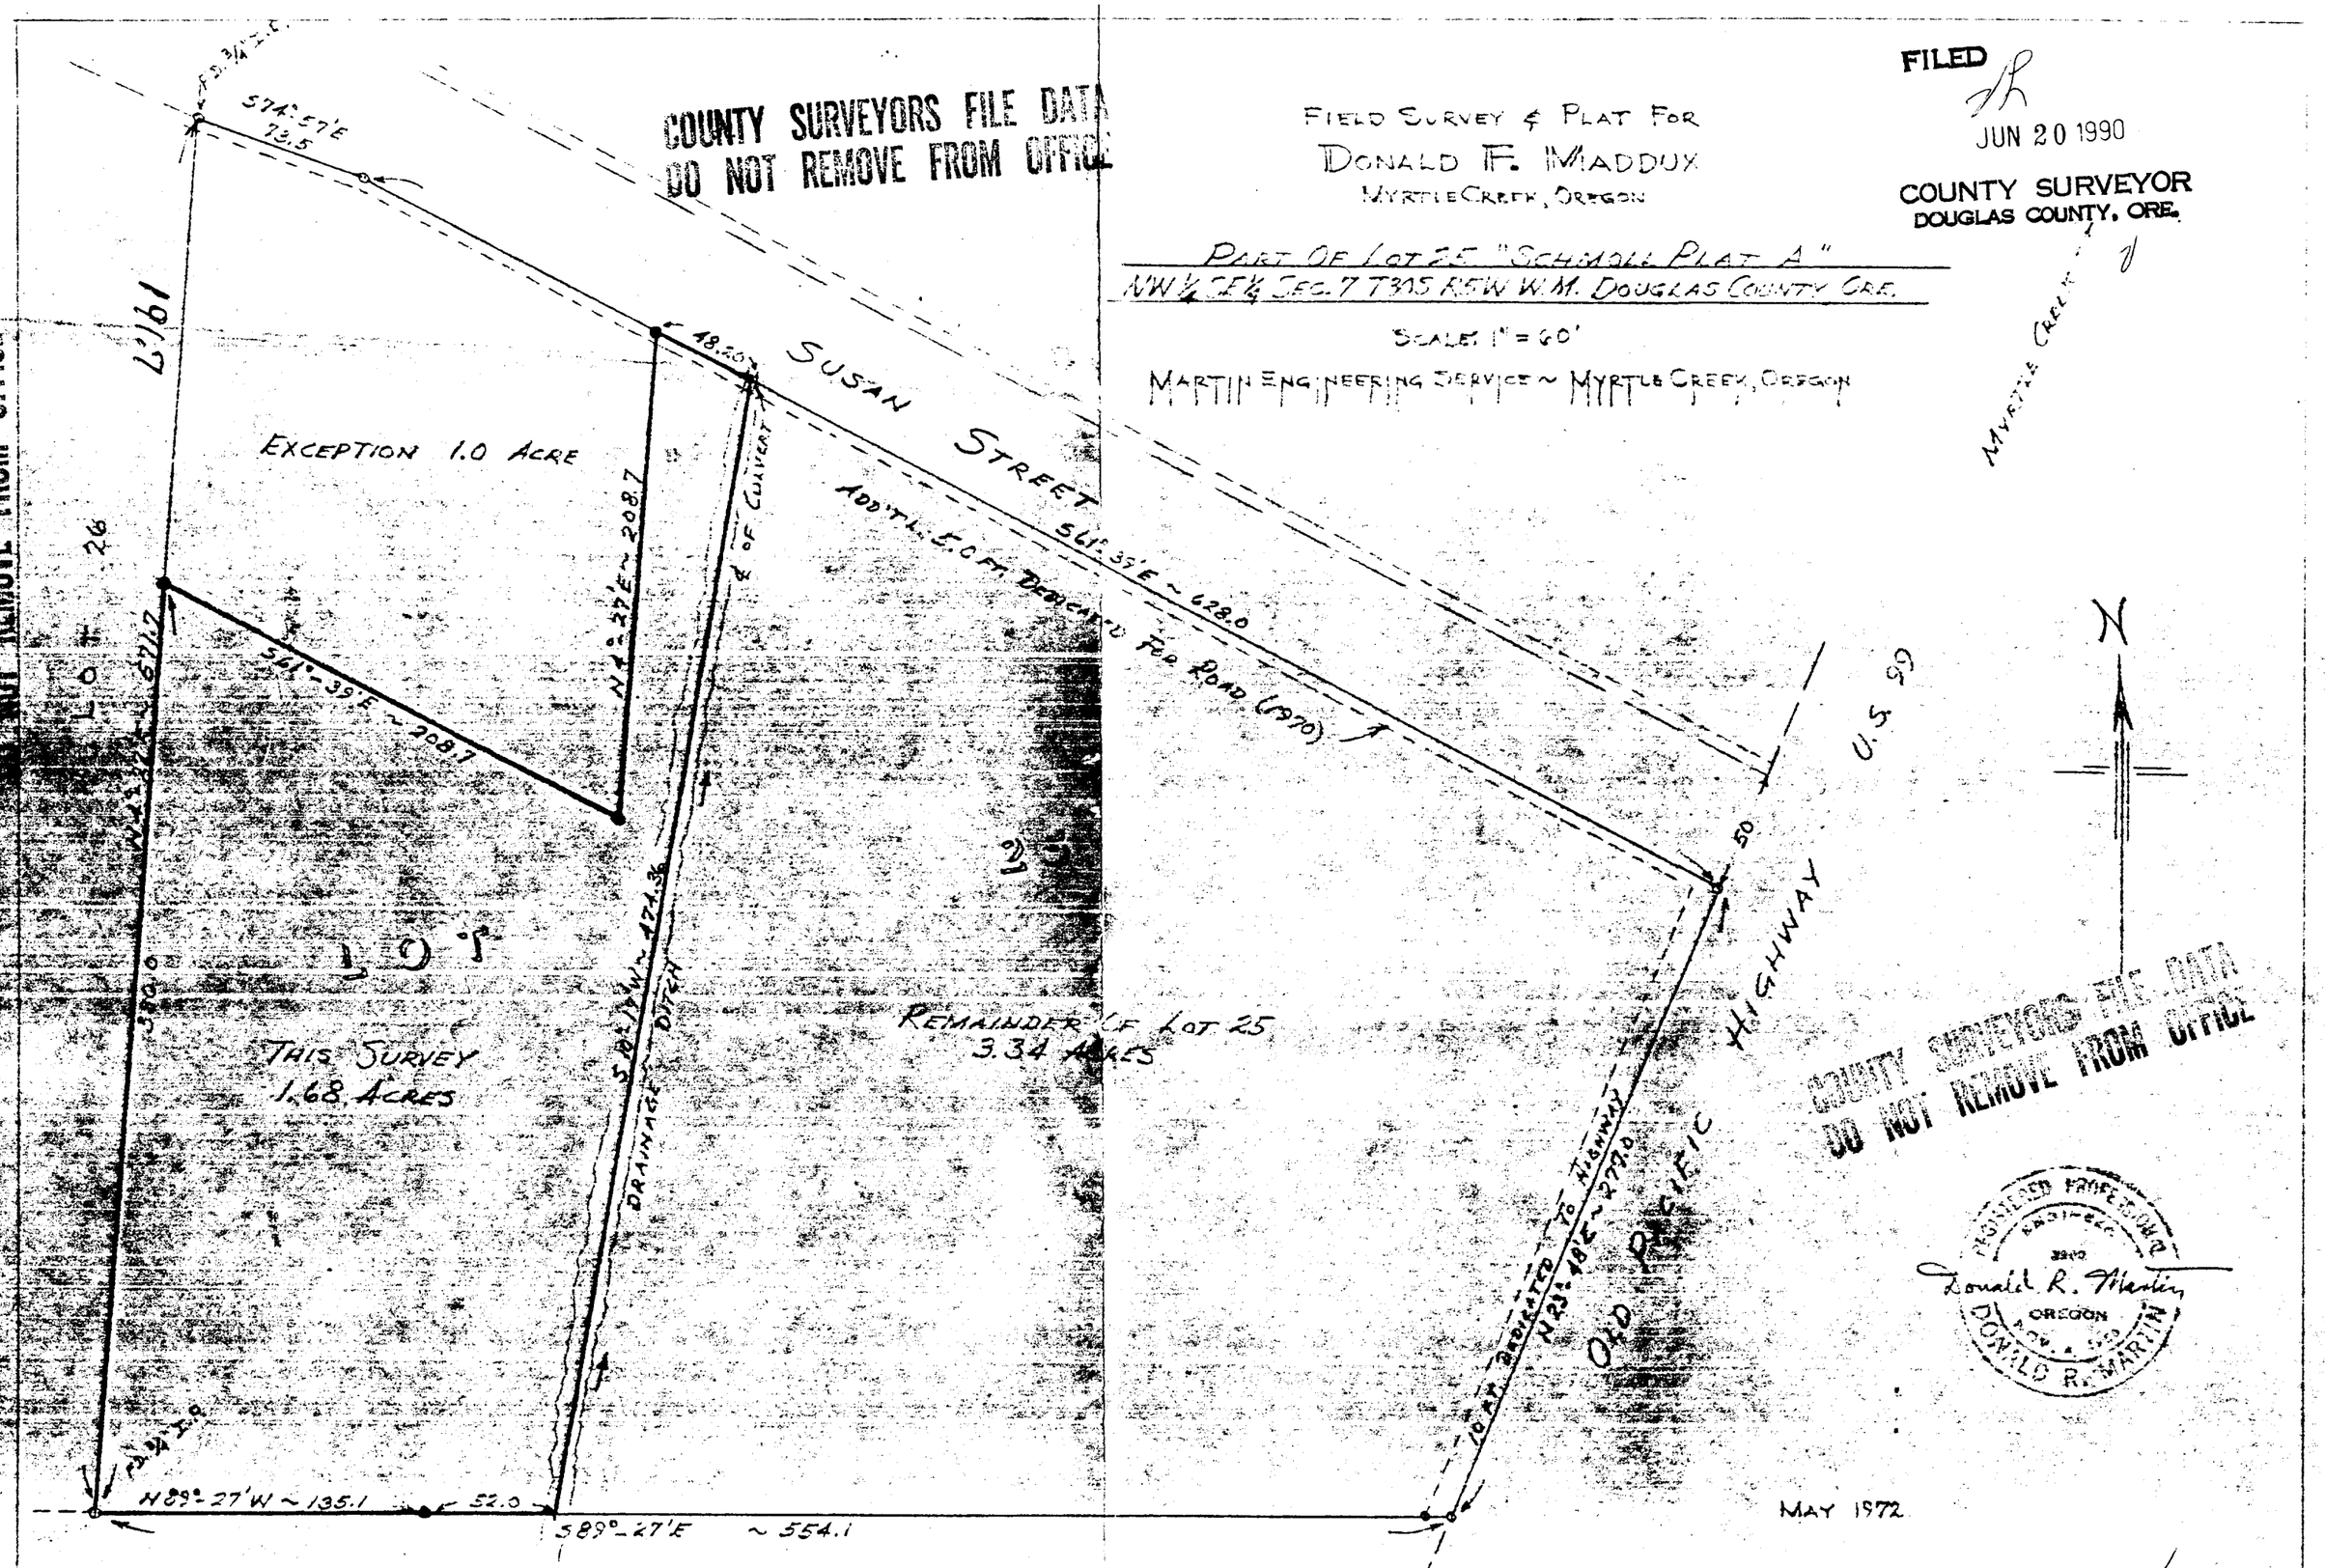

COUNTY SURVEYORS FILE DATA
DO NOT REMOVE FROM OFFICE

REGISTERED PROFESSIONAL ENGINEER
Donald R. Martin
OREGON
DONALD R. MARTIN

MAY 1972

C.S. File No. 63/118