



OFFICE OF THE
DOUGLAS COUNTY SURVEYOR

Station: GR-1 T 33³¹ S, R 4W, Sec 28

Date set: 1985

Set By (Agency): Douglas Co Public Works

Date of Report: 11/27/87

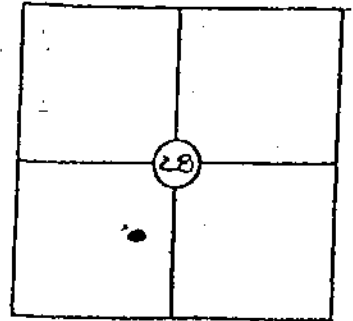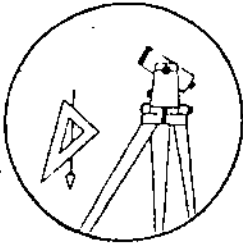

- Found
- New
- Reset
- Not Found
- Referenced
- Destroyed

VERTICAL CONTROL

Elevation: _____ NGS Line # _____ USGS Line # _____

Precision: _____ Agency: _____ Proj. # _____ Date: _____

HORIZONTAL CONTROL

South Zone State Plane Coordinates: Y(Northing) 441530.14 X(Easting) 1281079.88

Precision: _____ Agency: _____ Proj. # _____ Date: _____

Approximate Geographic Position: Latitude _____ Longitude _____

DESCRIPTION and TO REACH

DGPW Brass cap set in concrete 30' Rt of e of
Upper Cow Cr. Rd MP. 6.3

Take Exit # 88 from I-5 and proceed
east on Upper Cow Cr. Rd # 36 to MP. 6.3. Brass cap
is 30' from e of Co. Rd 36 and 117' from RPL
Pole # E 4003, and 53[±] ft from fence cor of field
access on Rt hand side of cow Rd. 36.

FILED

JAN 3 1992

COUNTY SURVEYOR
DOUGLAS COUNTY, ORE.

Reference Marks:

117' east
South of RPL pole # E 4003

NARRATIVE or NARRATIVE REFERENCE (STATION, LOCATION):

GR-2 can be seen directly from
GR-1

SKETCH:

Legend:

- ▲ DCSO Disc Set
- △ DCSO Disc Found
- Other Set as Noted
- Other Found as Noted
- Witness Post & Sign
- * * * * Fence
- — — Center Line

CS 63/136-1b

OFFICE OF THE
DOUGLAS COUNTY SURVEYOR



Station: GR-2

T ~~32~~³¹ S, R 4W, Sec 2

Date set: 1985

Set By (Agency): DCPW

Date of Report: 11/27/87

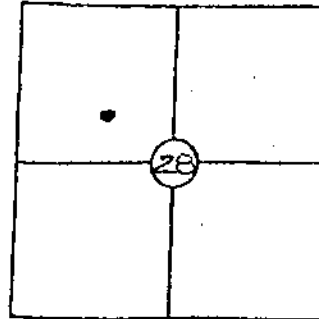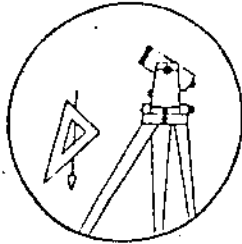

- Found
- New
- Reset
- Not Found
- Referenced
- Destroyed

VERTICAL CONTROL

Elevation: _____ NGS Line # _____ USGS Line # _____

Precision: _____ Agency: _____ Proj. # _____ Date: _____

HORIZONTAL CONTROL

South Zone State Plane Coordinates: Y(Northing) 442722.26 X(Easting) 1280554.52

Precision: _____ Agency: _____ Proj. # _____ Date: _____

Approximate Geographic Position: Latitude _____ Longitude _____

DESCRIPTION and TO REACH

DCPW Brass cap set in concrete 63' Lt of
centerline of Upper Cow Cr Rd # 36 @ M.P. 6.5.

Take Exit # 88 from I-5 and proceed east
on Co. Rd # 36 to M.P. 6.5. Cap is 63' to
the left of center of road, 2' from the fence
& 150' South of fence Cor. & Gate post on West
side of the Rd.

FILED

JAN 3 1992

Reference Marks:

COUNTY SURVEYOR
DOUGLAS COUNTY, ORE.

O.S. File No. 63/36-1c


OFFICE OF THE
DOUGLAS COUNTY SURVEYOR

Station: GR-3 T ~~32~~³¹ S, R 4W, Sec 28


Date set: 1985

Set By (Agency): DCPW

Date of Report: 11/27/87

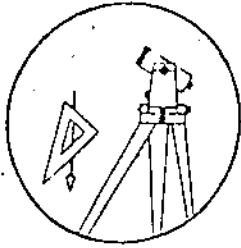

- Found
- New
- Reset
- Not Found
- Referenced
- Destroyed

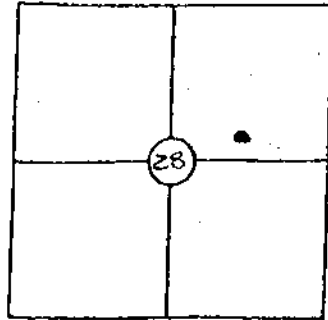

VERTICAL CONTROL

Elevation: _____ NGS Line # _____ USGS Line # _____

Precision: _____ Agency: _____ Proj. # _____ Date: _____

HORIZONTAL CONTROL

South Zone State Plane Coordinates: Y(Northing) 442650.73 X(Easting) 1262811.47

Precision: _____ Agency: _____ Proj. # _____ Date: _____

Approximate Geographic Position: Latitude _____ Longitude _____

DESCRIPTION and TO REACH

DCPW Brasscap set in concrete \approx 80 ft of Co Rd 36 @ MP 7. Located on top of cut bank \approx 60' above the Rd.

Take Exit # 88 from I-5 and proceed east on Upper Cow Cr Rd, Coastal no. 36 to M.P. 7. Cap is located on 60' high cut bank and 80' ft. of centerline

FILED

JAN 3 1992

COUNTY SURVEYOR
DOUGLAS COUNTY, ORE.

Reference Marks:

7

NARRATIVE or NARRATIVE REFERENCE (STATION, LOCATION):

GR-4 can be seen directly from GR-3
GR-5 can be seen through small amount
of brush from GR-3
GR-2 can be seen from GR-3

SKETCH:


Legend:

- ▲ DCSO Disc Set
- △ DCSO Disc Found
- Other Set as Noted
- Other Found as Noted
- Witness Post & Sign
- x x x x Fence
- — — Center Line


7
OFFICE OF THE
DOUGLAS COUNTY SURVEYOR

Station: G.R.-4
Date set: 1985
Set By (Agency): DCPW
Date of Report: 11/27/87

T ~~31~~ S, R 4W, Sec 27

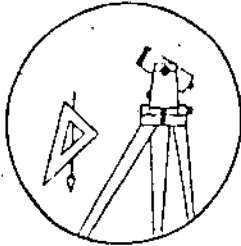

- | | |
|---|------------------------------------|
| <input checked="" type="checkbox"/> Found | <input type="checkbox"/> New |
| <input type="checkbox"/> Reset | <input type="checkbox"/> Not Found |
| <input type="checkbox"/> Referenced | <input type="checkbox"/> Destroyed |

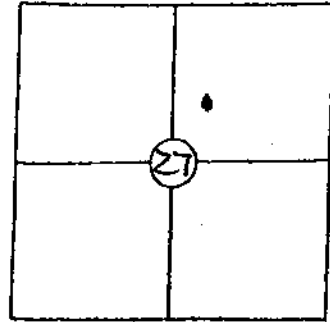

VERTICAL CONTROL

Elevation: _____ NGS Line # _____ USGS Line # _____
Precision: _____ Agency: _____ Proj. # _____ Date: _____

HORIZONTAL CONTROL

South Zone State Plane Coordinates: Y(Northing) 443114.75 X(Easting) 1287451.09
Precision: _____ Agency: _____ Proj. # _____ Date: _____
Approximate Geographic Position: Latitude _____ Longitude _____

DESCRIPTION and TO REACH

DCPW Brass cap set in concrete 72' Lt. of
& Sta 124+60 of Upper Cow Cr. Rd # 36
Take Exit #88 from I-5 and proceed
east on Upper Cow Cr. rd (Co. Rd # 36), to MP 7.97
Cap is located on a 10' high cut bank ≈ 72'
Lt of centerline sta 124+60

FILED

JAN 3 1992

COUNTY SURVEYOR
DOUGLAS COUNTY, ORE.

Reference Marks:

86° ft. from P.P.L power pole # E 4613

C.S. File No. 63/136-1G

7

NARRATIVE or NARRATIVE REFERENCE (STATION, LOCATION):

GR-3 can be seen from GR-4

SKETCH:

Legend:

- ▲ DCSO Disc Set
- △ DCSO Disc Found
- Other Set as Noted
- Other Found as Noted
- Witness Post & Sign

x-x-x-x Fence

— — — Center Line

CS 63/136 -1h


OFFICE OF THE
DOUGLAS COUNTY SURVEYOR

Station: GR-5 T ~~31~~ S, R 4W, Sec 34


Date set: 1985

Set By (Agency): DCPW

Date of Report: 11/27/87

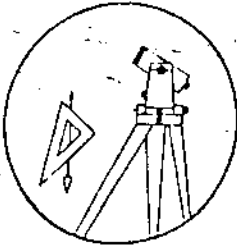

- Found
- New
- Reset
- Not Found
- Referenced
- Destroyed

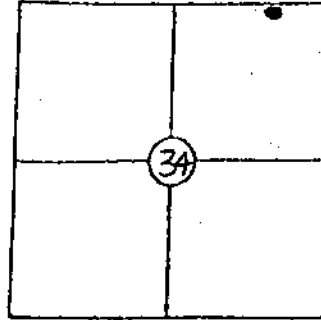

VERTICAL CONTROL

Elevation: _____ NGS Line # _____ USGS Line # _____
Precision: _____ Agency: _____ Proj. # _____ Date: _____

HORIZONTAL CONTROL

South Zone State Plane Coordinates: Y(Northing) 439453.73 X(Easting) 1288224.26
Precision: _____ Agency: _____ Proj. # _____ Date: _____
Approximate Geographic Position: Latitude _____ Longitude _____

DESCRIPTION and TO REACH

DCPW Brass cap set in concrete 51' Lt.
of centerline of Cow Cr. Rd #36 Sta 166-
Take Exit # 88 from I-5 and proceed
east on Co Rd #36, Upper Cow Cr. Rd to MP 8.75
Cap is located 51' Lt. of Sta 166- and
26' left of PPL power pole #E4625

FILED

JAN 3 1992

COUNTY SURVEYOR
DOUGLAS COUNTY, ORE.

Reference Marks:

26' from PPL Power pole #E4625 and
6' ft from Fence Cor.

C.S. File No. 63/136-11

NARRATIVE or NARRATIVE REFERENCE (STATION, LOCATION):

GR#3 can be seen through a
small amount of brush from G.R-5

SKETCH:


Legend:

- ▲ DCSO Disc Set
- △ DCSO Disc Found
- Other Set as Noted
- Other Found as Noted
- Witness Post & Sign
- X-X-X-X Fence
- Center Line


OFFICE OF THE
DOUGLAS COUNTY SURVEYOR

Station: GR-6
Date set: 1985
Set By (Agency): DCPW
Date of Report: 11/27/87

T ³¹~~32~~ S, R 4W, Sec 33

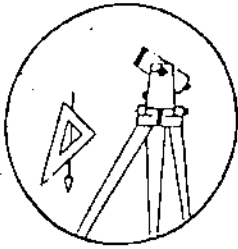

- Found
- New
- Reset
- Not Found
- Referenced
- Destroyed

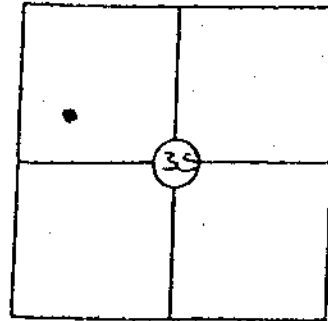

VERTICAL CONTROL

Elevation: _____ NGS Line # _____ USGS Line # _____
Precision: _____ Agency: _____ Proj. # _____ Date: _____

HORIZONTAL CONTROL

South Zone State Plane Coordinates: Y(Northing) 437482.95 X(Easting) 1290676.53
Precision: _____ Agency: _____ Proj. # _____ Date: _____
Approximate Geographic Position: Latitude _____ Longitude _____

DESCRIPTION and TO REACH

DCPW Brass cap set in concrete 2' below
the rd and 35' Lt of centerline of Upper Cow
Cr. Rd # 36

Take exit #88 from I-5 and proceed east
on Upper Cow Creek Rd # 36 to MP 9.45
Cap is 35' Lt of centerline and 56^s ft west
of power pole # E 4636 and 25^s ft east of
inlet of a 42" cimp culvert

FILED

JAN 3 1992

COUNTY SURVEYOR
DOUGLAS COUNTY, ORE.

Reference Marks:

56^s ft west of P.P.L Power pole # E 4636
and 35^s ft from E of Cow Rd #36, 25^s ft east
of the inlet of a 42" cimp culvert

C.S. File No. 63/136-1K

7

NARRATIVE or NARRATIVE REFERENCE (STATION, LOCATION):

Lined area for narrative or narrative reference.

SKETCH:

Legend:

- ▲ DCSO Disc Set
- △ DCSO Disc Found
- Other Set as Noted
- Other Found as Noted
- Witness Post & Sign

x-x-x-x Fence

— — — Center Line

OFFICE OF THE
DOUGLAS COUNTY SURVEYOR


Station: GR-7

T ~~31~~ S, R 4W, 35 Sec


Date set: 1985

Set By (Agency): DCRW

Date of Report: 11/27/87

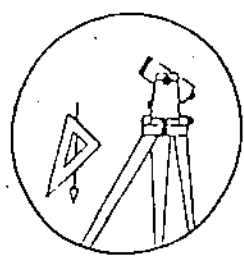

- Found
- New
- Reset
- Not Found
- Referenced
- Destroyed

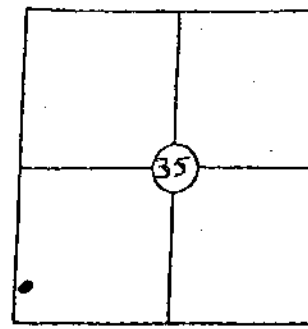

VERTICAL CONTROL

Elevation: _____ NGS Line # _____ USGS Line # _____
 Precision: _____ Agency: _____ Proj. # _____ Date: _____

HORIZONTAL CONTROL

South Zone State Plane Coordinates: Y(Northing) 434668.81 X(Easting) 1289441.50
 Precision: _____ Agency: _____ Proj. # _____ Date: _____
 Approximate Geographic Position: Latitude _____ Longitude _____

DESCRIPTION and TO REACH

DCRW Brasscap set in concrete 4'
below Upper Cow Cr. Rd MP 10.15 and
38° ft Right of center line and 13° ft North
west of PRL Power pole # E 4647

Take Exit # 88 from I-5 and proceed
easterly on Upper Cow Cr Rd # 36 to MP
10.15. Cap is 38° ft Rl. of center line of
road: 13ft. NW. of PRL Power Pole # E 4647

FILED

JAN 3 1992

COUNTY SURVEYOR
DOUGLAS COUNTY, ORE.

Reference Marks:

C.S. File No. 63/136-1M

NARRATIVE or NARRATIVE REFERENCE (STATION, LOCATION):


C-132 can be seen from GR-7

SKETCH:

Legend:

- ▲ DCSO Disc Set
- △ DCSO Disc Found
- Other Set as Noted
- Other Found as Noted
- Witness Post & Sign
- x-x-x-x-x Fence
- Center Line

CS 63/136-1N

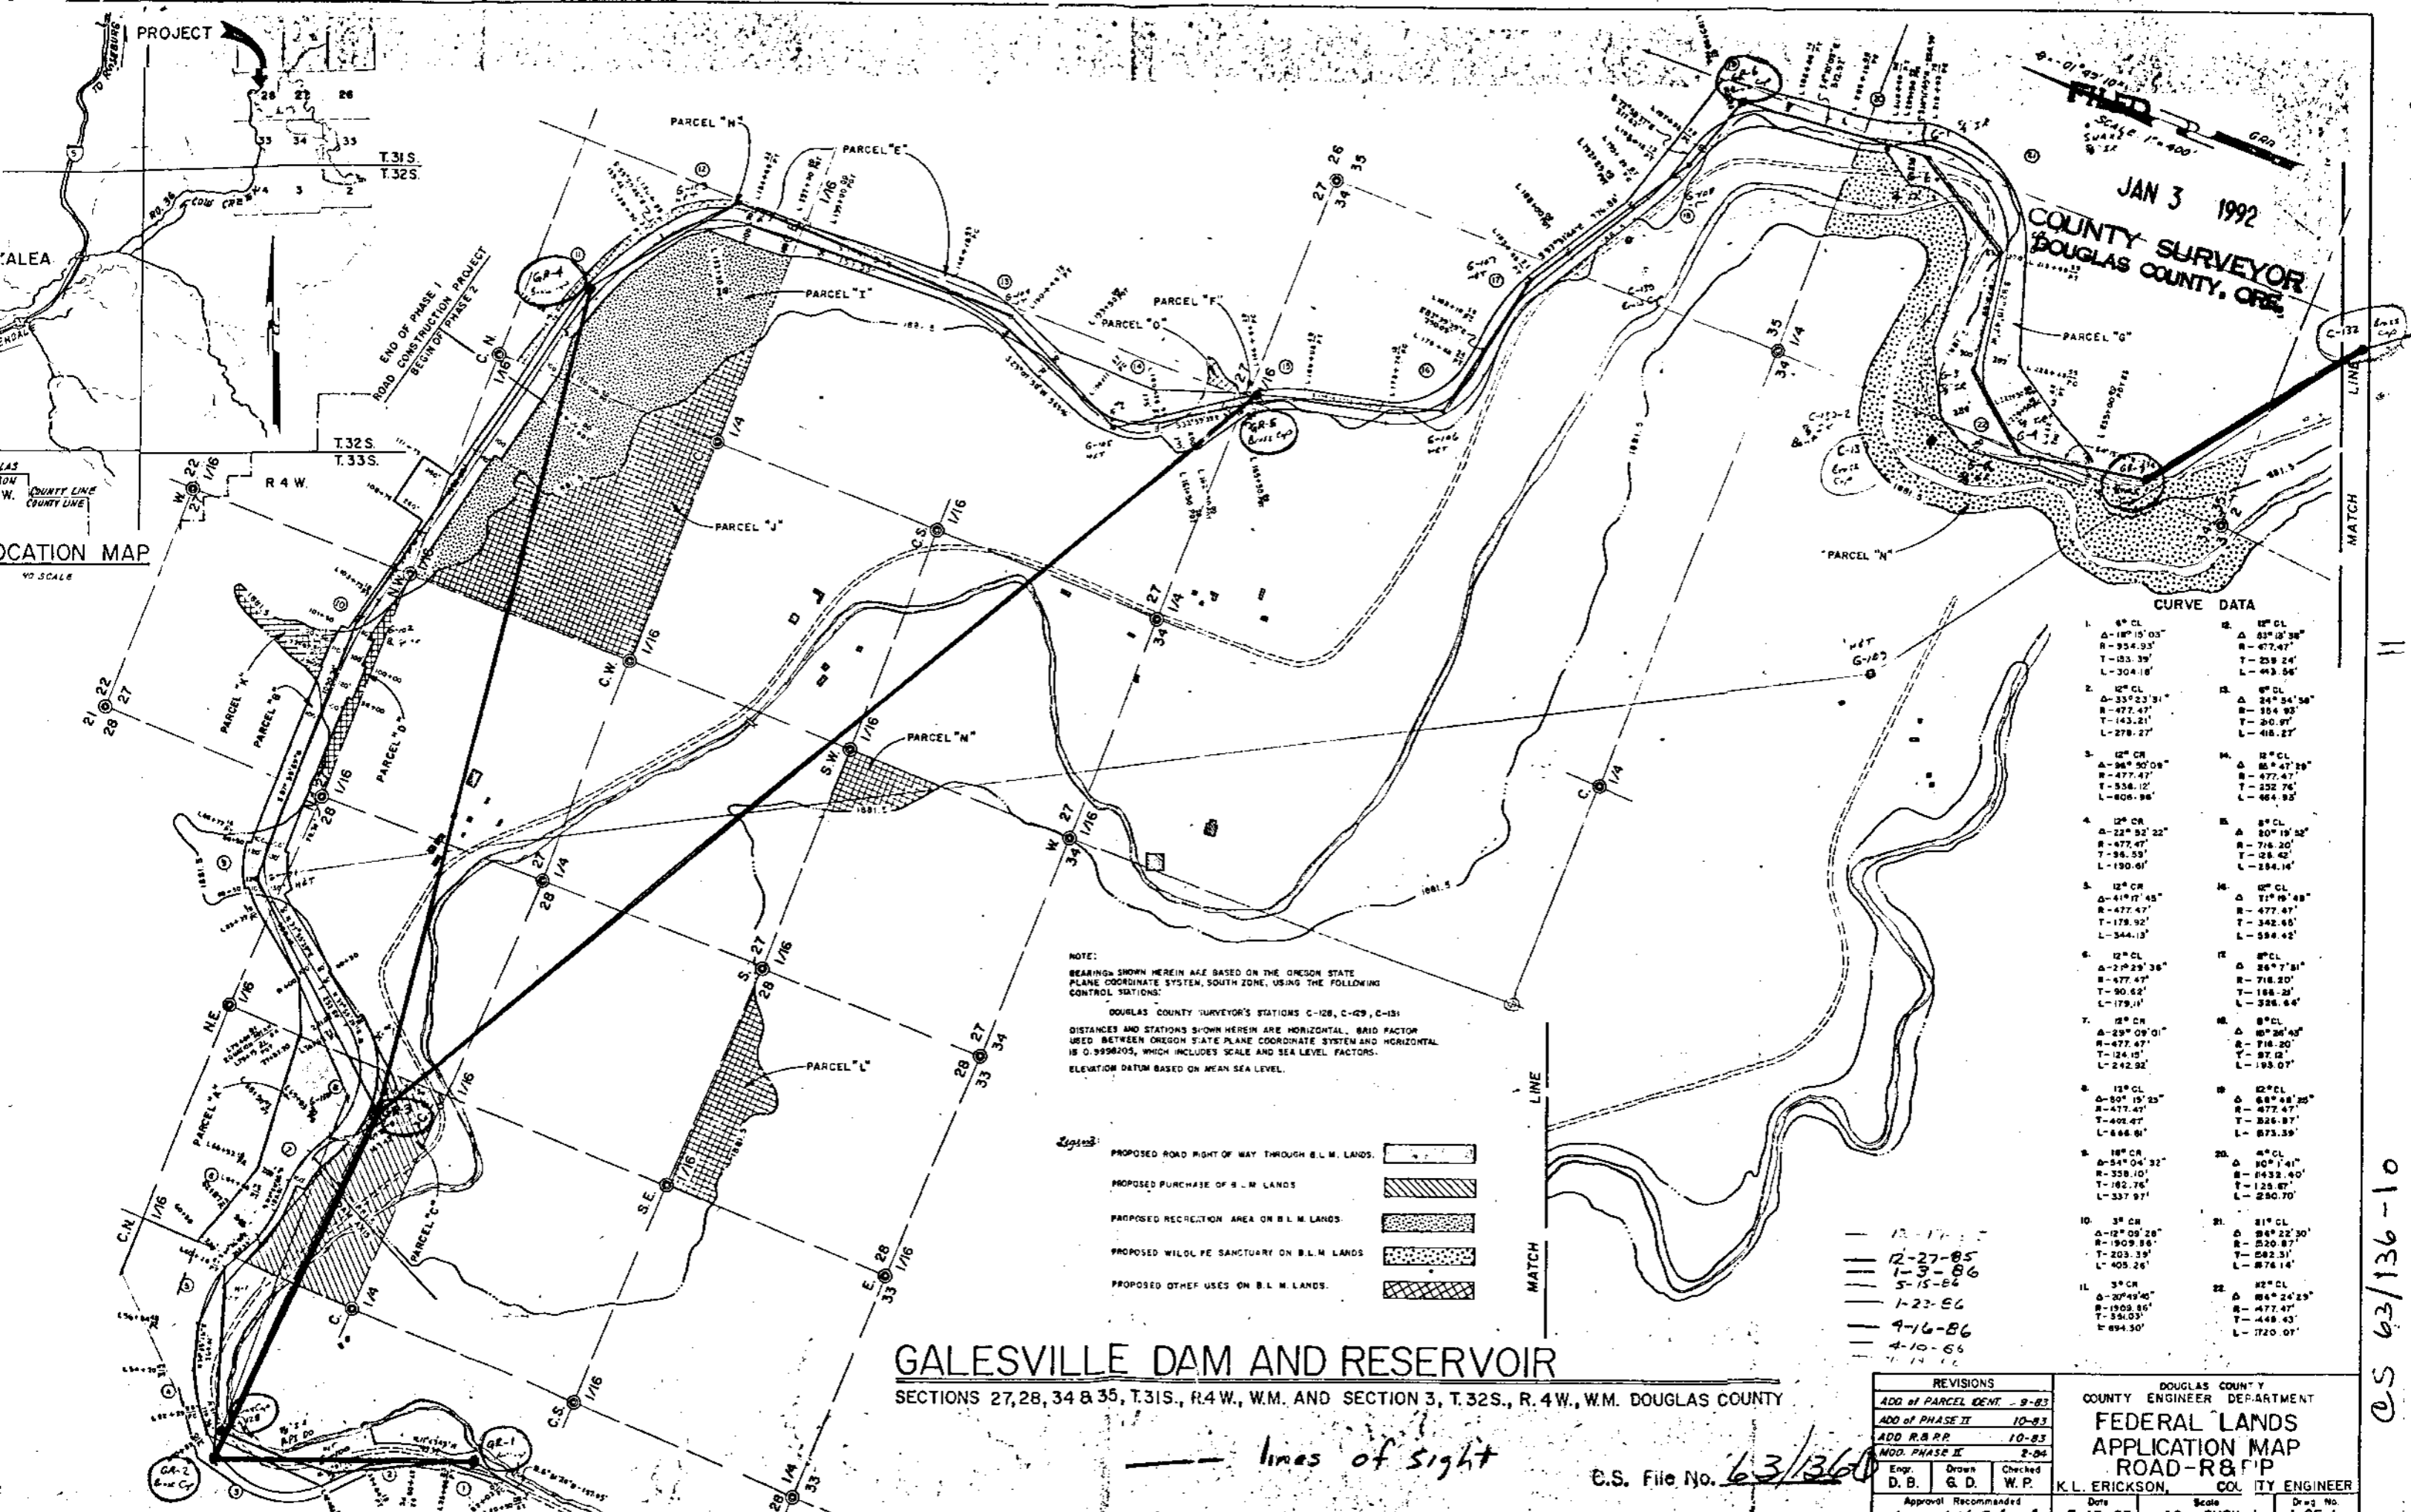

JAN 3 1992
 COUNTY SURVEYOR
 DOUGLAS COUNTY, ORE.

CURVE DATA


--	--	---	--	---	--	---	--	---	---	--	--

NOTE:
 BEARINGS SHOWN HEREIN ARE BASED ON THE OREGON STATE PLANE COORDINATE SYSTEM, SOUTH ZONE, USING THE FOLLOWING CONTROL STATIONS:
 DOUGLAS COUNTY SURVEYOR'S STATIONS C-128, C-129, C-131
 DISTANCES AND STATIONS SHOWN HEREIN ARE HORIZONTAL. SAID FACTOR USED BETWEEN OREGON STATE PLANE COORDINATE SYSTEM AND HORIZONTAL IS 0.9998205, WHICH INCLUDES SCALE AND SEA LEVEL FACTORS.
 ELEVATION DATUM BASED ON MEAN SEA LEVEL.

- Legend:**
- PROPOSED ROAD RIGHT OF WAY THROUGH B.L.M. LANDS. [Symbol]
 - PROPOSED PURCHASE OF B.L.M. LANDS [Symbol]
 - PROPOSED RECREATION AREA ON B.L.M. LANDS [Symbol]
 - PROPOSED WILDLIFE SANCTUARY ON B.L.M. LANDS [Symbol]
 - PROPOSED OTHER USES ON B.L.M. LANDS [Symbol]

GALESVILLE DAM AND RESERVOIR
 SECTIONS 27, 28, 34 & 35, T.31S., R.4 W., W.M. AND SECTION 3, T.32S., R.4 W., W.M. DOUGLAS COUNTY

— lines of sight

C.S. File No. 63/136

REVISIONS ADD OF PARCEL IDENT. - 9-83 ADD OF PHASE II 10-83 ADD R.R.P.P. 10-83 MOD. PHASE II 2-84			DOUGLAS COUNTY COUNTY ENGINEER DEPARTMENT FEDERAL LANDS APPLICATION MAP ROAD-R&FP K.L. ERICKSON, COUNTY ENGINEER		
Eng. D.B.	Drawn G.D.	Checked W.P.	Approval Recommended	Date 7-13-83	Scale AS SHOWN
[Signature]			Date	Scale	Draw No. 1 OF 1

OS 63/136-10