M114-28

FILED
JAN 13 1992
COUNTY SURVEYOR
DOUGLAS COUNTY, ORE.

OREGON CORNER RESTORATION FORM

Section 22 Township 21S Range 10W

County Douglas Date 12-17-91

CORNER DESIGNATION
North ¼ Corner
Section 22

x Condition Report Only
___ Not Found
___ Renewed
___ Unrecorded
___ Surveyed In
___ Referenced Out

Previous Renewals/Surveys, etc. Original G.L.O. Survey by William Theil in 1879. G.L.O. Survey by Fred Rodolf, Elmer Strickler and Gerald Sorrels in 1918. C.S. M95-80A and M95-80B by Herman Pieske in 1983.

Monument(s) & Accessories Found: (Condition and Source)

Found 1983 U.S. Forest Service Reference Monument as set in C.S. M95-80A.
The 1879 Corner tree bears N 45°00'E, 4.00'. Found 1918 iron pipe, with brass cap missing, on S.W. side of corner tree.
16" Fir , S50E, 15.8' (No Marks) , 1879 BT. Record S50E, 15.8'
13" Alder , N62E, 57.3' (Bark Scribed), 1983 BT. Record N62E, 57.0'
16" Hemlock, S17W, 24.0' (Scribe Vis.) , 1983 BT. Record S17W, 24.1'

Monument Detail

Sketch

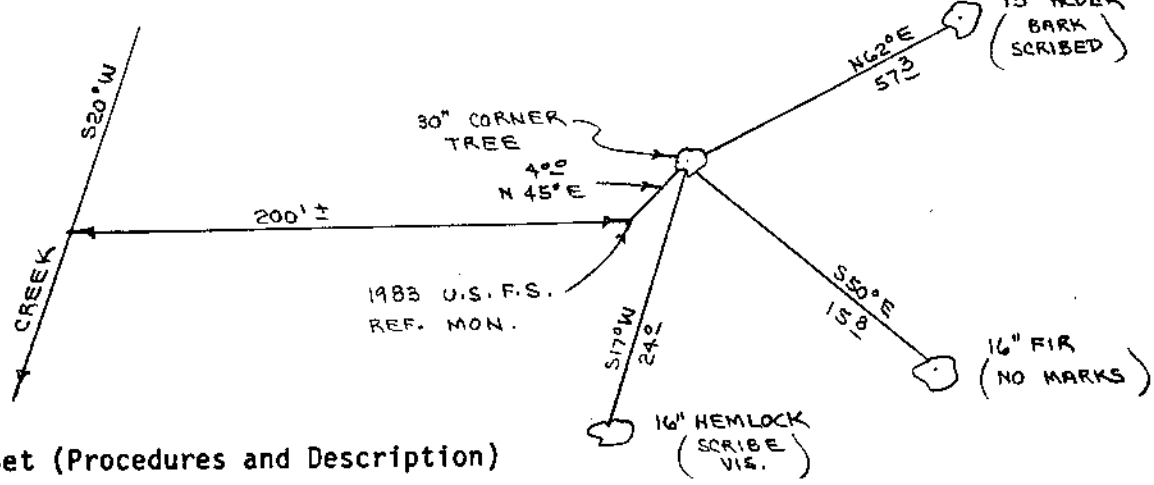

Monument Set (Procedures and Description)

New Accessories

Location & Comments

Corner lies on South slope about 200' East of Creek
Creek bears N20E and S20W.

Compass Declination 20½
Firm/Agency Roberts Surveying Inc.
Address 29 West 29th St. Eugene, Oregon 97405
Party Chief Ted Baker
Notes
Witness Brad Cole

Surveyor's Seal

REGISTERED PROFESSIONAL LAND SURVEYOR
Lee Roberts
L. D. ROBERTS

C.S. File No. 63/139-1A

M114-28

FILED

JAN 13 1992

COUNTY SURVEYOR
DOUGLAS COUNTY, ORE.

OREGON CORNER RESTORATION FORM

Section 22 Township 21S Range 10W

County Douglas Date 12-16-91

CORNER DESIGNATION

South ¼ Corner
Section 22

x Condition Report Only
___ Not Found
___ Renewed
___ Unrecorded
___ Surveyed In
___ Referenced Out

Previous Renewals/Surveys, etc. Original G.L.O. Survey by William Theil in 1879, G.L.O. Survey by Fred Rodolf, Elmer Strickler and Gerald Sorrels in 1918, C.S. M95-80A and M95-80B by Herman Pieske in 1983.

Monument(s) & Accessories Found: (Condition and Source)

Found 1918 G.L.O. Iron Pipe and Brass Cap, top broken off.
25" Fir "Shell", S82W, 17.5' (Scar Vis.), 1918 BT. Record N74W, 17.8'
No Evidence of 10" Alder.

Monument Detail

Sketch

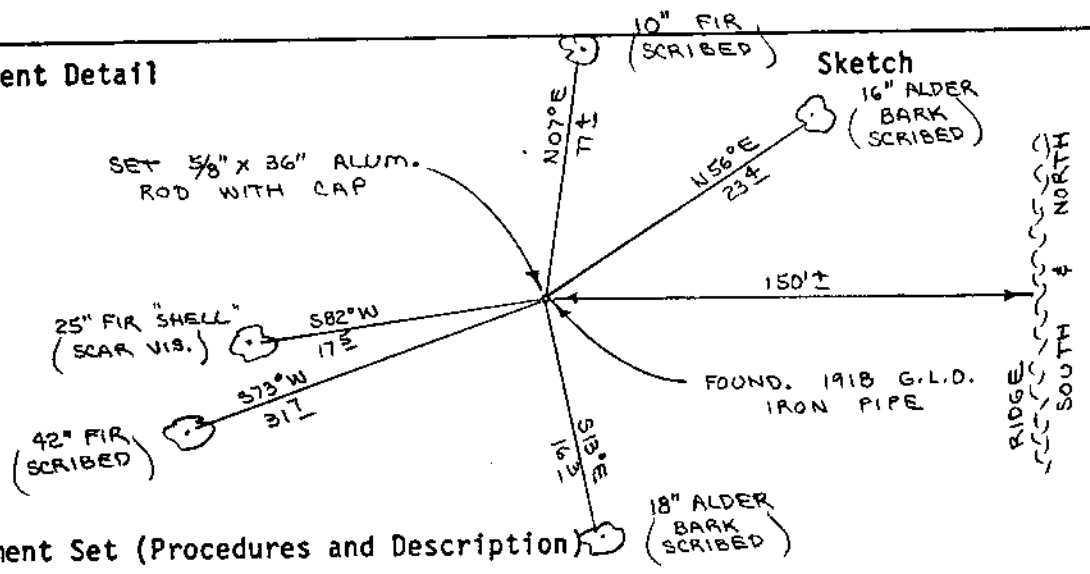

Monument Set (Procedures and Description)

Set, 5/8" x 36" Aluminum Rod with Aluminum Cap beside G.L.O. Iron pipe.
(Buried purple magnetic marker under 36" aluminum rod)
10" Fir , N07E, 77.4' (Scribed/Painted Red)
16" Alder, N56E, 23.4' (Bark Scribed/Painted Red)
18" Alder, S13E, 16.3' (Bark Scribed/Painted Red)

New Accessories

42" Fir , S73W, 31.7' (Scribed/Painted Red)

Location & Comments

Corner lies on West slope about 150' West of ridge. Ridge bears North-South

Compass Declination 20½

Firm/Agency Roberts Surveying, Inc.

Address 29 West 29th St. Eugene, Oregon 97405

Party Chief Ted Baker

Notes Ted Baker

Witness Brad Cole

Surveyor's Seal

REGISTERED PROFESSIONAL LAND SURVEYOR
Leo Roberts
OREGON
L. D. ROBERTS
1039

C.S. File No. 63/138-1/B