Rm. 122 - Courthouse
Roseburg, OR 97470

DOUGLAS COUNTY SURVEYOR

VISIT
CORNER ~~RENEWAL REQUEST~~

Ph. 672-3311
Ext. 114

Section 11 Twp. 24S Rge. 2W

Date 3/17/92

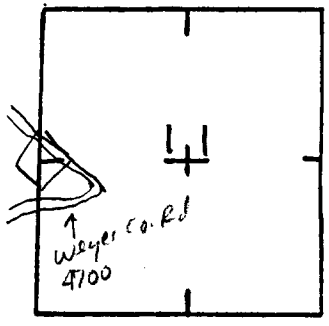

Condition of Corner and Accessories: 1970 DC Surveyor Brass Cap in thick 20yr old reprod patch. OK
2 Yew tree BT's in good shape (??? Yew trees are endangered now however)

FILED
APR 2 1992
COUNTY SURVEYOR
DOUGLAS COUNTY, ORE.

TO REACH: (Please show approximate distances, clearcuts, roads, fences, etc.) This corner is 50 Ft. below (South) of Weyer Co. Road 4700 (BLM No. 24-2-4.0)
(see Map)

Notify immediately prior to renewal visit? Yes ____ No ____
Notify following renewal visit? Yes ____ No ____
Is corner in immediate danger of being lost or disturbed? Yes ____ No ____

Name Bill May
Address BLM
777 NW GU Blvd.
Telephone 440-4930 306

ADDITIONAL COMMENTS I put up an S-8 Aluminum location poster on S. edge of Road.

✓

13/44-1

C.S. File No.

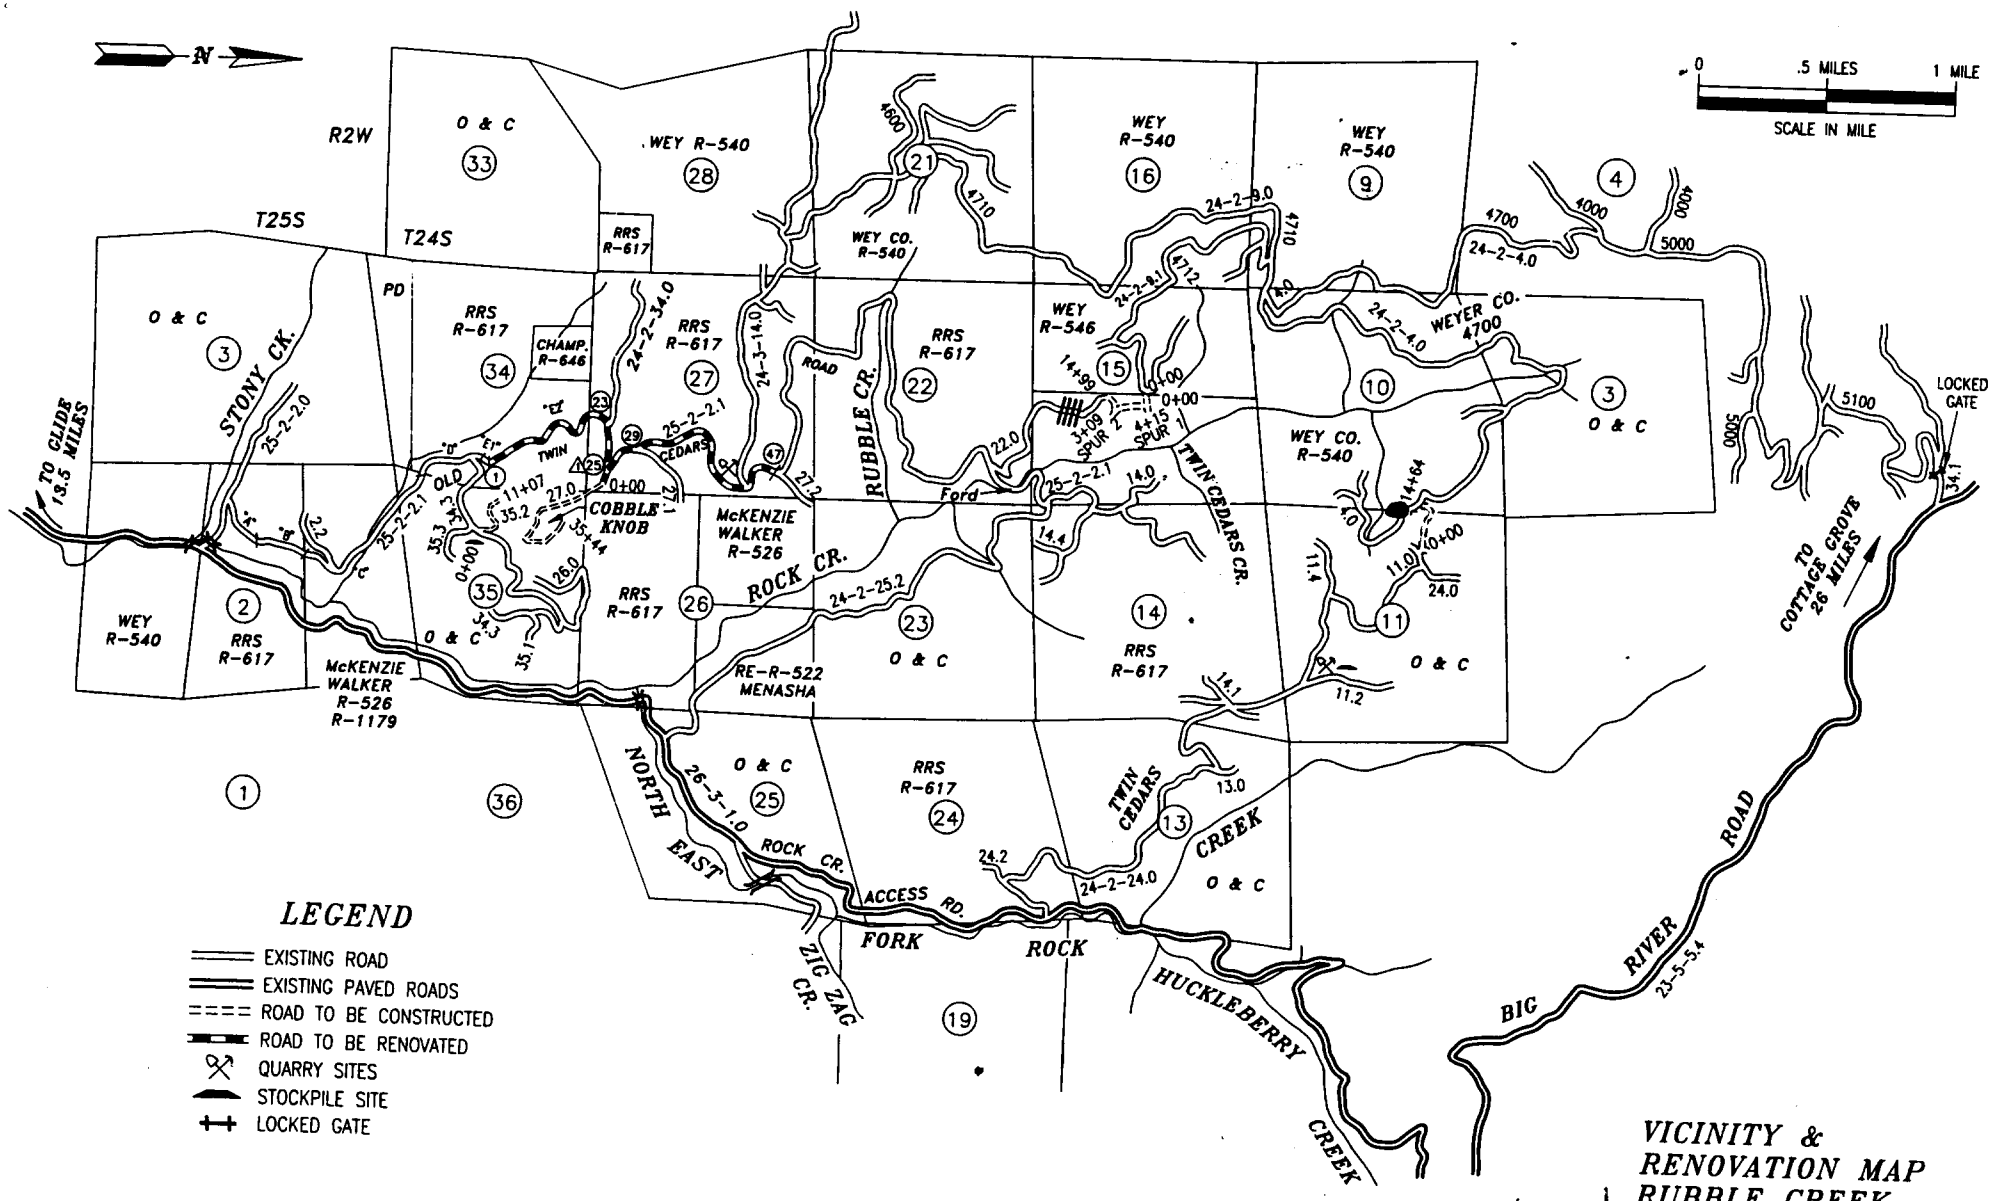

VICINITY & RENOVATION MAP
RUBBLE CREEK
T24S, R2W, W.M.

C.S. File No. 63/140-1

SHEET ____

FILED
APR 2 1992
COUNTY SURVEYOR
DOUGLAS COUNTY, ORE.

3-17-92

Douglas County Surveyor

Enclosed are visitation records for several corners I visited in the past year.
There is one Renewal request.

Bill May
North Umpqua Resource Area
BLM
Roseburg
6-440-4930 Ext. 306

Rec'd 3/18/92

Treat as Corner reports
Per Ed

J

U.S. File No. 63/140