M 119-52

FILED

Date: 3/9/95 By: JP
This survey consists of:
Map: M 119-52
Narrative
Corner Plat: C.S. 63/161

DOUGLAS COUNTY SURVEYOR

OREGON CORNER RESTORATION FORM

Section 30 Township 30S Range 3W

County Douglas Date Feb. 28, 1995

Corner Designation

CE 1/16

___ Condition Report Only
___ Not Found
___ Renewed
___ Unrecorded
X Surveyed In
___ Referenced Out

Previous Renewals/Surveys, etc.
None

Monument(s) & Accessories Found: (Condition and Source)
N/A

Monument Detail

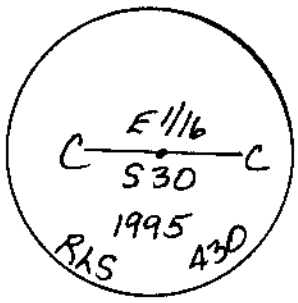

Sketch

Monument Set (Procedures and Description)
I set a 3" Brass Cap on a 2½" x 30" Iron Pipe from which a:

New Accessories
12" D. Fir BT, I scribed "CE 1/16 S30 BT" bears N75°W, 101½ feet.
26" D. Fir BT, I scribed " " " " " " bears S33°W, 151½ feet.
6 Foot Steel Fence Post, I set, bears North, 1½ foot.

Location & Comments
Fence Corner bears N45°W, 55½ feet from Corner.
(Fence bears South & West from fence corner.)

Compass Declination 20°E
Firm/Agency Shaner Engineering, Inc.
Address P.O. Box 1430 Roseburg, Oregon 97470
Party Chief B. Shaner
Notes " "
Witness David Snyder

Surveyor's Seal
REGISTERED PROFESSIONAL LAND SURVEYOR
Bruce A Shaner
OREGON OCT. 4, 1967 BRUCE A. SHANER 430
Expires June 30, 1996

C.S. File No. 63/161-14