R

GOVERNMENT CORNER RESTORATION FORM

FILED

NOV 1 1989

COUNTY SURVEYOR
DOUGLAS COUNTY, ORE.

Township 27 S Range 3 W Sec. 7 County DOUGLAS

State OR Date 10/31/89 No.

Corner Designation

RG 4 | RG 3

12	7
13	18

- X Condition Report Only
- ___ Not Found
- ___ Renewed
- ___ Unrecorded
- ___ Surveyed In
- ___ Referenced Out

Previous Renewals RG4 ✓ #95 RG 3 ✓ #93

MONUMENT DETAIL

Monument(s) Found: (Condition and Source)

1917 G.L.O 2½" DIA BRASS CAP ON A 2" O.D. IRON PIPE, PROTRUDING 18" ABOVE GROUND. SURROUNDED BY A LOOSE PILE OF ROCKS.

U.S. GENERAL LAND OFFICE SURVEY

T27S

R4W	R3W
S12	S7
S13	S18

1917

Accessories Found:

BT'S FROM 1917 RESURVEY

40" NOW 44" DIA. D.FIR, WITH A FULLY HEALED SINGLE BLAZE, BEARS N17°E, 11.2 FT (AGREES WITH REC).

30" NOW 50" DIA. D.FIR, HAS A BURNT OUT BACK, AND A FULLY HEALED SINGLE BLAZE, BEARS S58°W, 28.4 FT (AGREES WITH REC.)

12" NOW 24" DIA. D.FIR WITH A FULLY HEALED BLAZE, BEARS N54°W, 29.5 FT (AGREES WITH REN #95 REC.)

8" NOW 12" DIA. 2FT HIGH D.FIR STUMP, TOP SHOWS EVIDENCE OF BLAZE, BEARS S16¾°E, 40.3 FT (AGREES WITH REC.).

10" NOW 16" DIA. D.FIR WITH A FULLY HEALED DOUBLE BLAZE, BEARS S41°E, 34.0 FT (AGREES WITH REC.) FROM REN #95

U.S. File No. 64/3-1

RENEWAL

Monument Set (Procedure and Description)

NONE

Monument Detail

N/A

New Accessories

NONE

Sketch of Monument, Acessories, and General Area

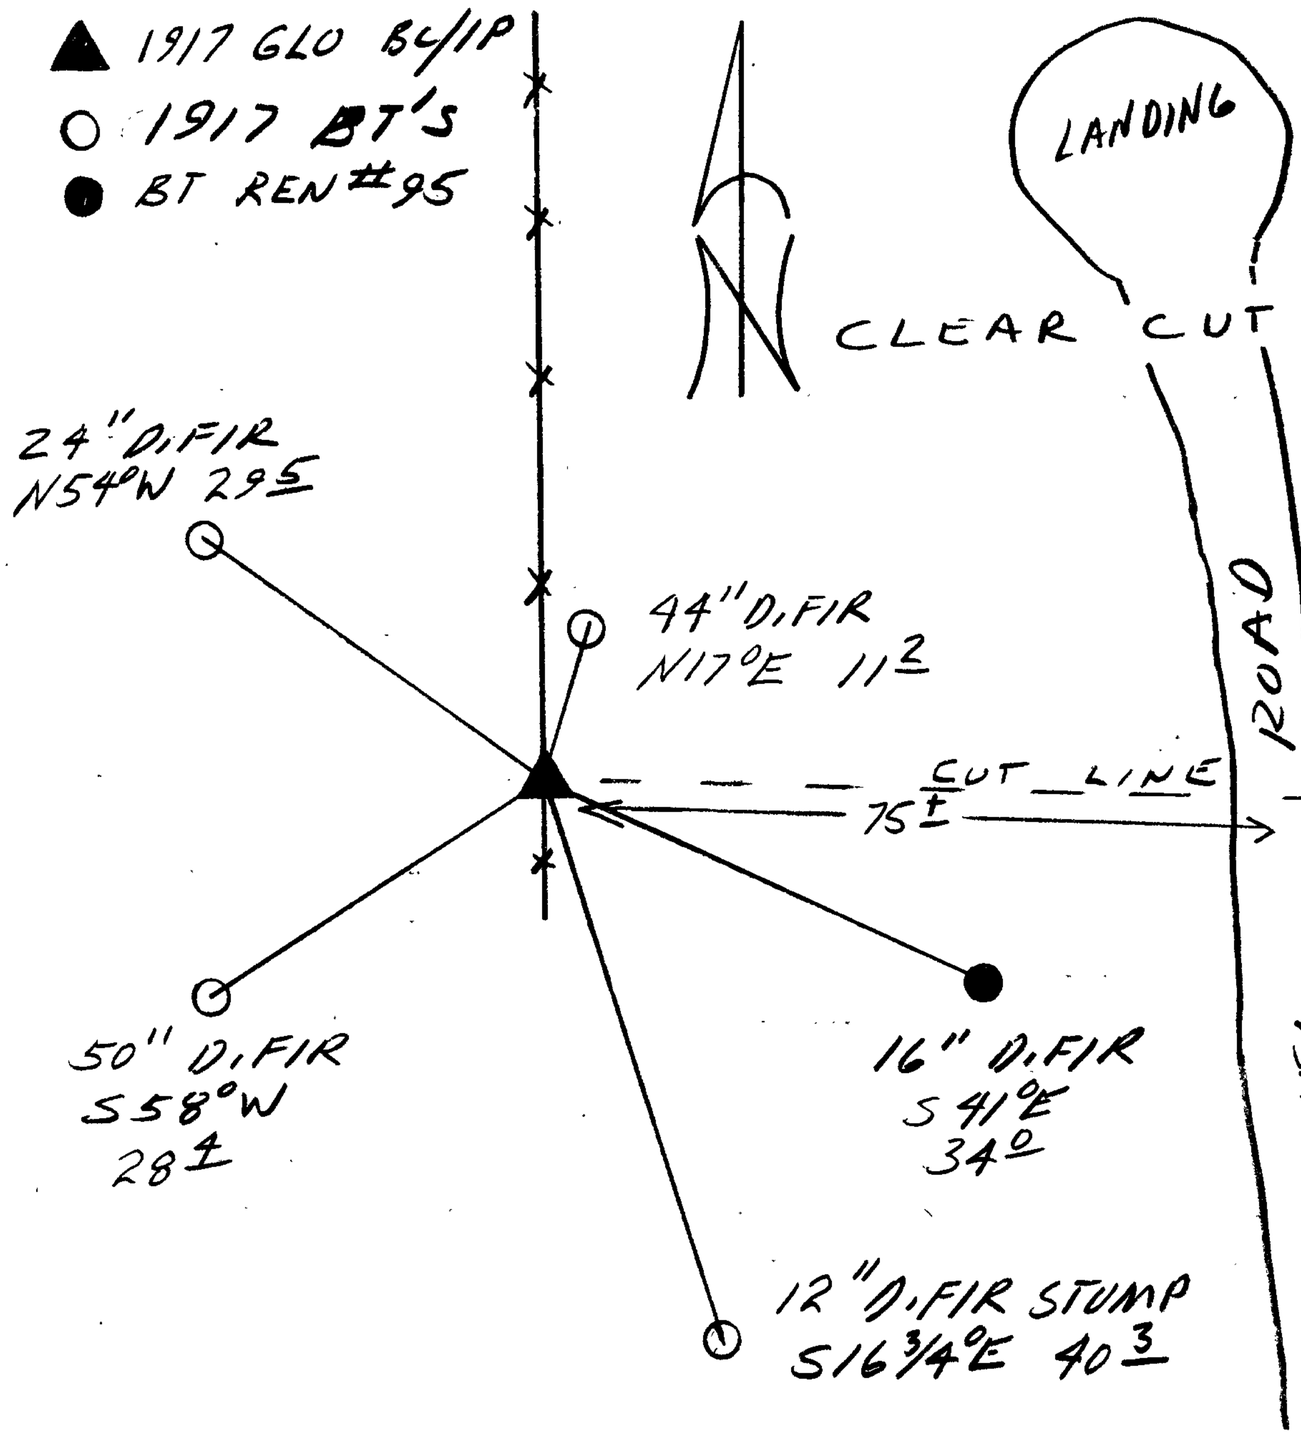

Location & Comments

CORNER IS 2 FT FROM THE SOUTH END OF A NORTH RUNNING FENCE LINE.

CORNER IS ON EAST SIDE, NEAR TOP OF A NORTH EAST RUNNING RIDGE

Comp. Declin. 18°E
Agency OCSO
Party Chief LARRY E MONREAN
Notekeeper RANDALL W SMITH
Witnesses TERRY FRANSEN

Address

Surveyor's Seal

REGISTERED
PROFESSIONAL
LAND SURVEYOR

Larry E. Monrean

OREGON
JULY 13, 1979
LARRY E. MONREAN
#1830