GOVERNMENT CORNER RESTORATION FORM

FILED

Township 22 S Range 10 W Sec. 33 County DOUGLAS

State OR Date 3/4/92 No.

MAR 6 1992

COUNTY SURVEYOR
DOUGLAS COUNTY, ORE.

Corner Designation

1/4 S33 | S34

____ Condition Report Only
____ Not Found
✓ Renewed
____ Unrecorded
____ Surveyed In
____ Referenced Out

Previous Renewals #92

MONUMENT DETAIL

Monument(s) Found: (Condition and Source)

5" NOW 16" DIA. D. FIR WITH SCRIBING VISIBLE ON OPENED WEST BLAZE "1/4". ORIG. COR. TREE.

N/A

Accessories Found:

28" NOW 29" DIA. D. FIR WITH A PARTIALLY HEALED SINGLE BLAZE, ILLEGIBLE SCRIBING VISIBLE, BEARS N 57 1/2° E, 32.4 FT (AGREES WITH REC) #92

24" NOW 27" DIA. D. FIR WITH A PARTIALLY HEALED SINGLE BLAZE SCRIBING VISIBLE "1/4 S33 BT" BEARS N17°W, 8.2 FT (AGREES WITH REC) #92

#142 ✓

G.S. File No. 64/24-1 C

RENEWAL

Monument Set (Procedure and Description)

Monument Detail

NA

New Accessories

24" DIA. D. FIR DOUBLE BLAZED AND SCRIBED "Y4S 33 CS BT" BEARS S 22°W, 5.2 FT

14" DIA D. FIR DOUBLE BLAZED AND SCRIBED "Y4S34CS BT" BEARS S 87°E, 21.7 FT

Sketch of Monument, Acessories, and General Area

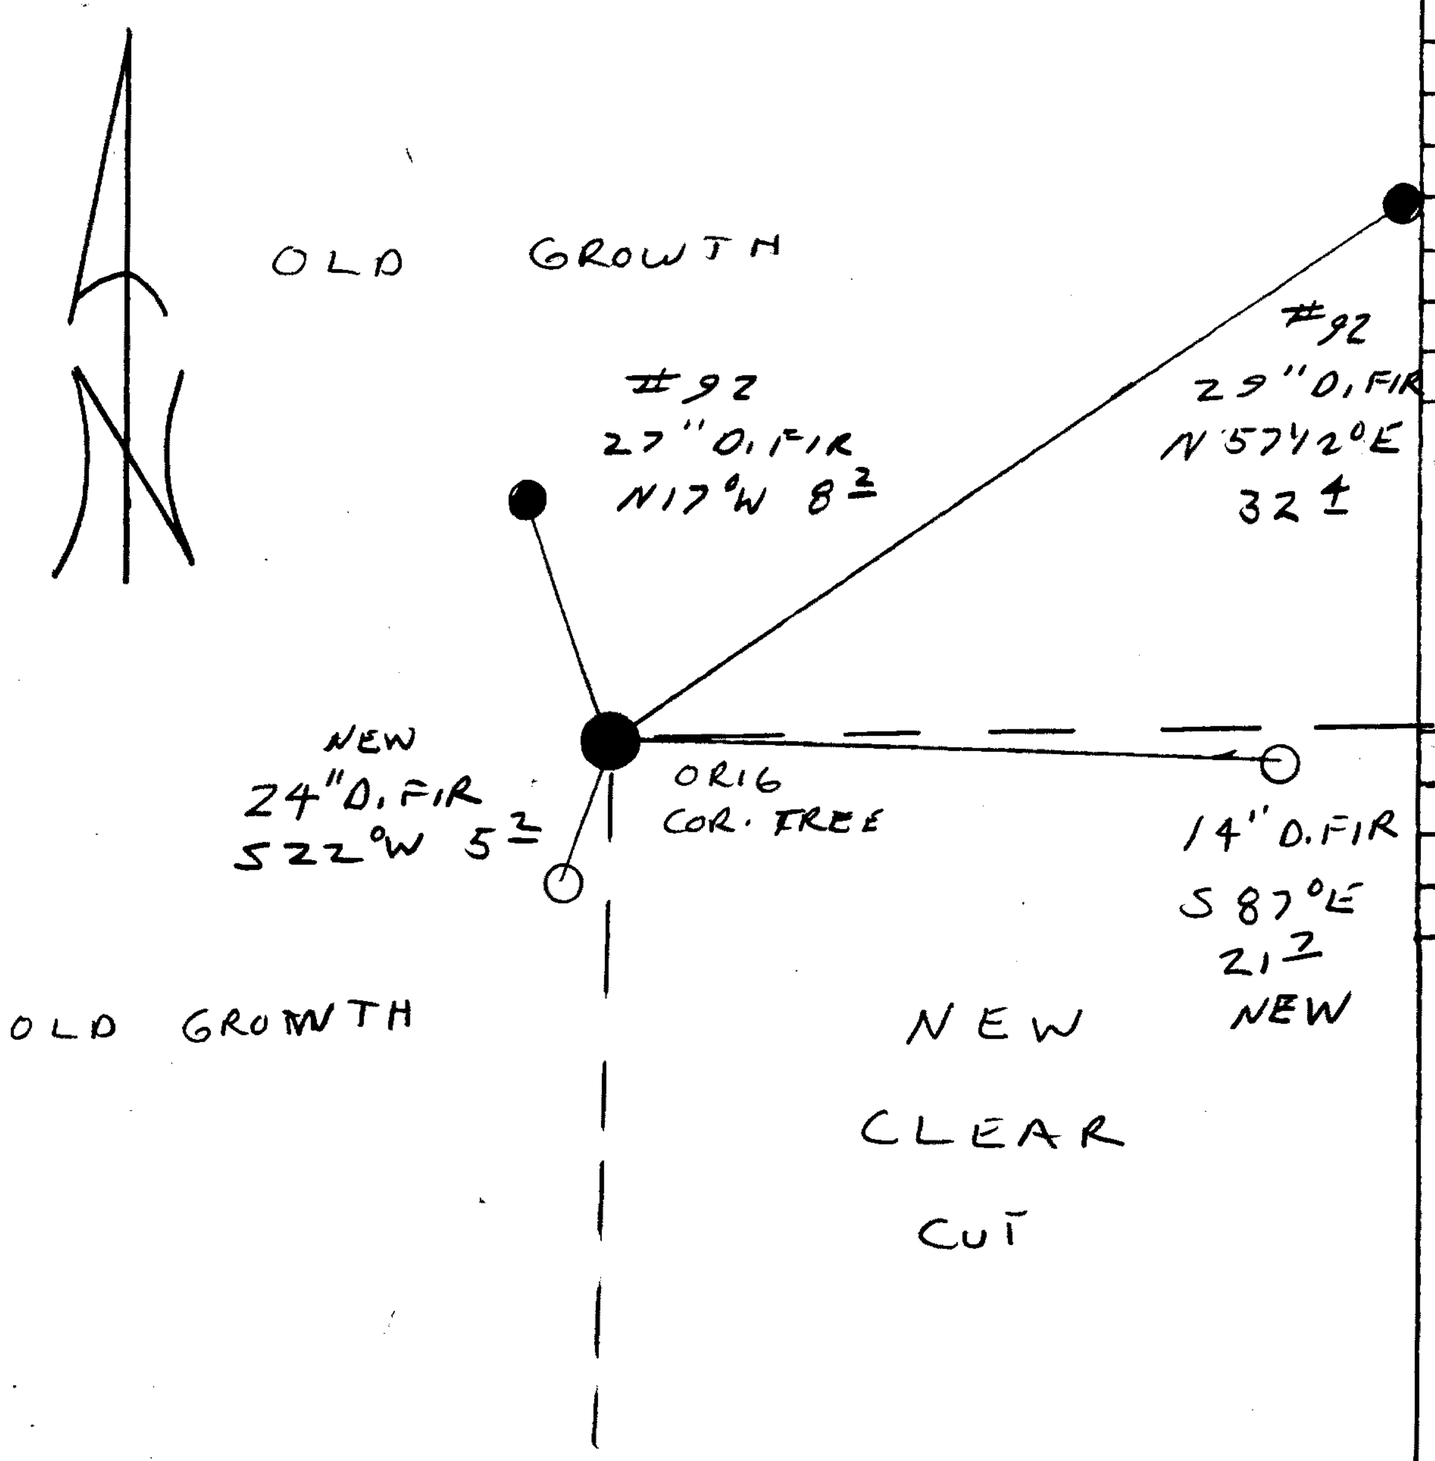

Location & Comments

Comp. Declin. 18°E
Agency DCSO
Party Chief RANDALL W SMITH
Notekeeper Randall W Smith
Witnesses

Address

Surveyor's Seal

REGISTERED
PROFESSIONAL
LAND SURVEYOR

Randall W Smith

OREGON
JULY 25, 1990
RANDALL W. SMITH
2469