R

GOVERNMENT CORNER RESTORATION FORM

FILED
MAR 18 1992
COUNTY SURVEYOR
DOUGLAS COUNTY, ORE.

Township 22S Range 6W Sec. 27 County DOUGLAS

State OR Date 2/25/92 No.

Corner Designation

S27 / S34 | S26

___ Condition Report Only
___ Not Found
✓ Renewed
___ Unrecorded
___ Surveyed In
___ Referenced Out

Previous Renewals NOT FILED HAINES, 1963 BLM

Monument(s) Found: (Condition and Source)

3X4" DIA. BLM BRASS CAP ON A 2½" O.D. IRON PIPE PROTRUDING 3" ABOVE GROUND (1963 BLM)

HAINS "T" IRON IS 0.4 FT SOUTH EAST OF BC/IP PROTRUDING 4" ABOVE GROUND (NOT FILED HAINES)

MONUMENT DETAIL

U.S. CADASTRAL SURVEY
T 22S R 6W

C S27 / C S34 | S26

1963
BUREAU OF LAND MANAGEMENT

Accessories Found:

1 20" NOW DOWN AND ROTTED NO SCRIBING VISIBLE ROOT HOLE BEARS S36°W, 16.5 FT (AGREES WITH REC.) ORIG. BT

ORIG. NW BT IS GONE.

2 6" NOW 11" DIA DOWN D.FIR WITH A FULLY HEALED SINGLE BLAZE, ROOT HOLE BEARS S80°W, 16.8 FT (AGREES WITH REC.) (NOT FILED HAINES)

3 6" NOW 8" DIA. DEAD D.FIR WITH A FULLY HEALED SINGLE BLAZE, BEARS N78°W, 22.8 FT (AGREES WITH REC.). (NOT FILED HAINES)

#162X

C.S. File No. 64/24-5 C

RENEWAL

Monument Set (Procedure and Description)

NONE

Monument Detail

N/A

New Accessories

A 24"DIA 1" TALL G. FIR STUMP A BOAT SPIKE IS DRIVEN THROUGH BT TAG NEAR CENTER ON TOP OF STUMP. BS BEARS N 67°W, 24.0 FT.

B 14"DIA "G. FIR DOUBLE BLAZED AND SCRIBED "CC T22S R6W S34 CS BT" BEARS S 3°W, 50.5 FT

C 16"DIA G. FIR DOUBLE BLAZED AND SCRIBED "CC T22S R6W S34 CS BT" BEARS S 43°W, 25.0 FT

D 18"DIA. G. FIR DOUBLE BLAZED AND SCRIBED "CC T22S R6W S34 CS BT" BEARS S 78°W, 43.4 FT

Sketch of Monument, Acessories, and General Area

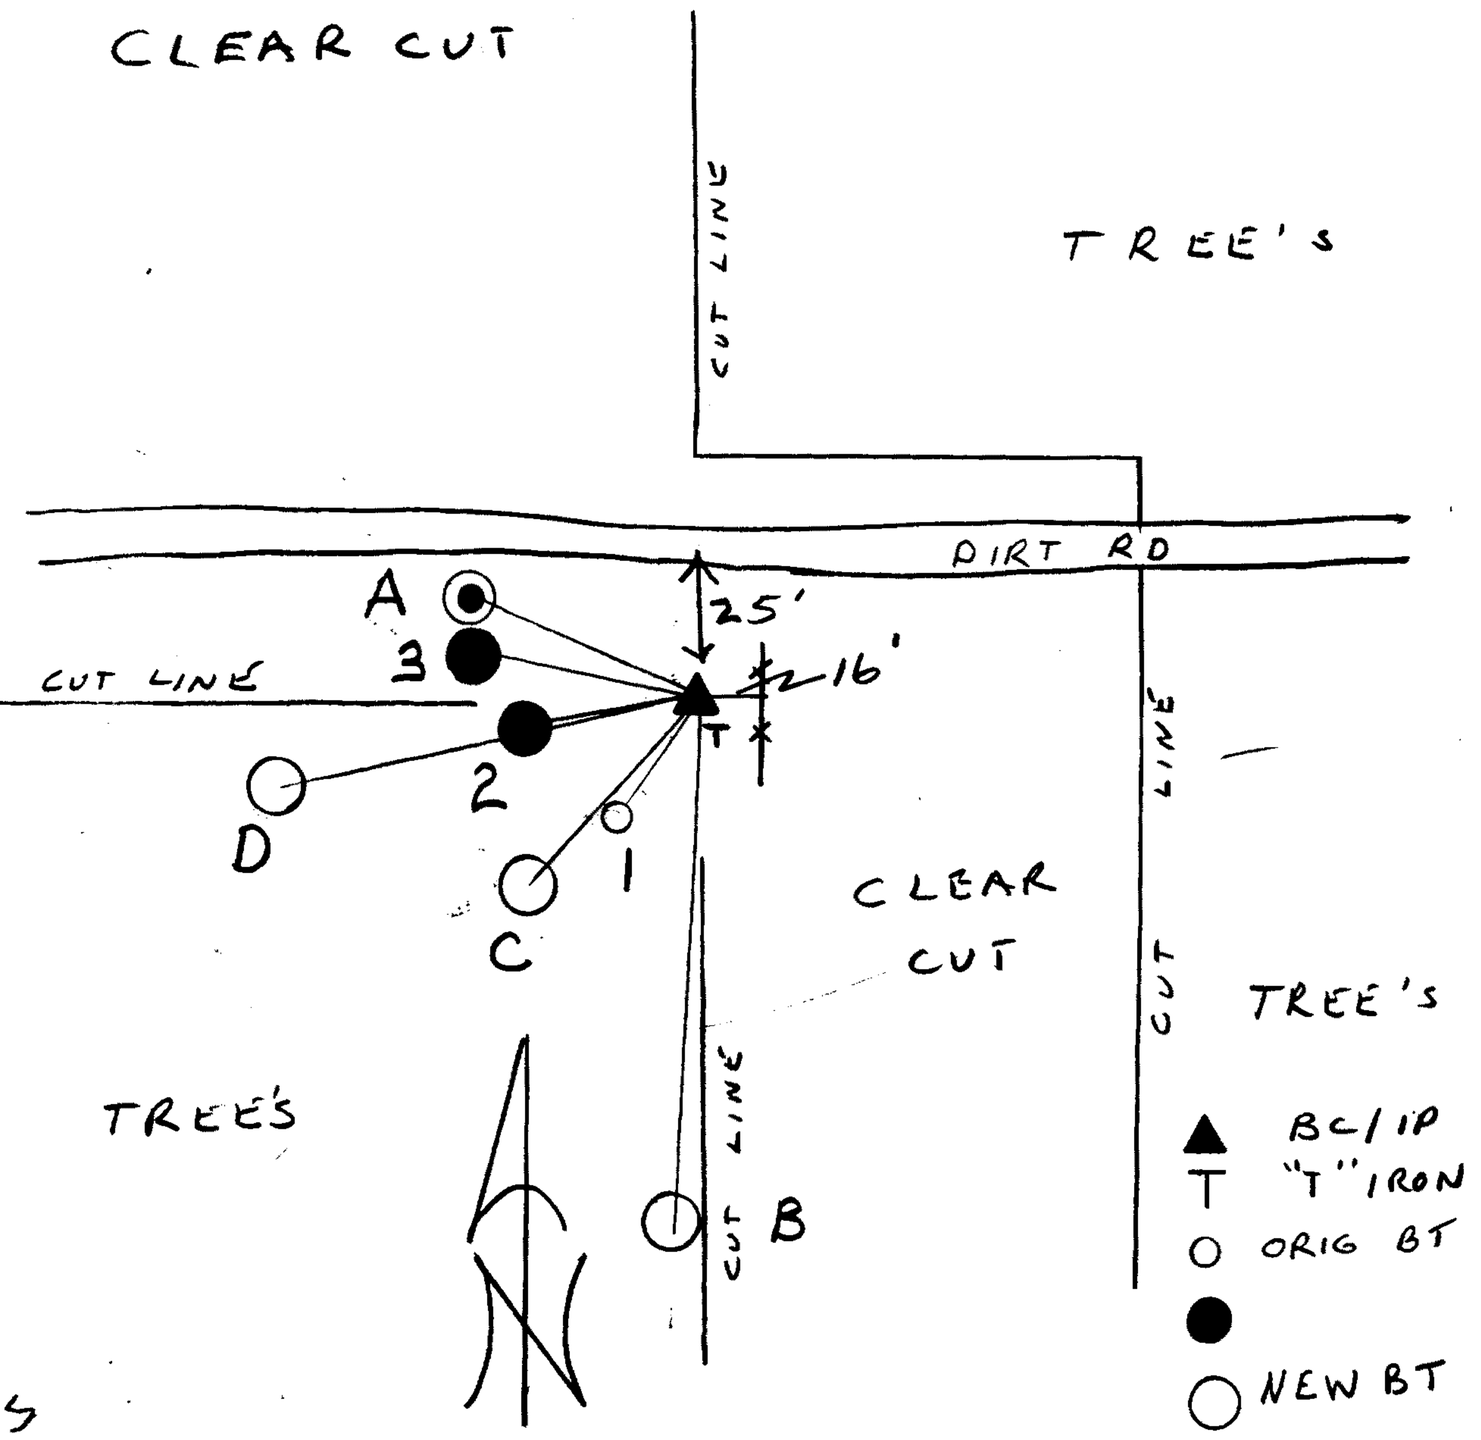

Location & Comments

Comp. Declin. 18°E

Agency DCSO

Party Chief RANDALL W. SMITH

Notekeeper Randall W Smith

Witnesses JOHN PIKE

Address

Surveyor's Seal

REGISTERED
PROFESSIONAL
LAND SURVEYOR

Randall W Smith

OREGON
JULY 25, 1990
RANDALL W. SMITH
2469