GOVERNMENT CORNER RESTORATION FORM

FILED

JUL 8 1992

COUNTY SURVEYOR
DOUGLAS COUNTY, ORE.

Township 27 S Range 4 W Sec. 29 County DOUGLAS

State OR. Date 7-8-92 No.

Corner Designation

30	29
31	32

____ Condition Report Only
____ Not Found
x Renewed
____ Unrecorded
____ Surveyed In
____ Referenced Out

Previous Renewals 1959 DCSO REN, 1970 BLM SURVEY, M 01-26

Monument(s) Found: (Condition and Source)

FOUND IRON PIPE WITH BRASS CAP MARKED AS NOTED. FIRMLY SET, 1 FOOT HIGH, WOOD FENCE POST ALONG EAST EDGE

MONUMENT DETAIL

COUNTY SURVEYOR'S OFFICE
T 27 S R 4 W

S 30	S 29
S 31	S 32

1959

Accessories Found:

- NO ORIGINAL QT'S FOUND.

* 1959 RENEWAL QT'S.

- 12" OAK N 82 1/4 E NOT FOUND.

- 30" FIR NOW DEAD STANDING 36" DIAM. WITH WELL HEALED DOUBLE BLAZE BEARS S ~~10 1/2°~~ 73° W 38 3/ FT (REC. 38.9 FT). THIS TREE TO BE REMOVED

- 13" W. OAK NOW 18" DIAM. WITH WELL HEALED DOUB. BLAZE BEARS S 10 1/2 E 17 7/ FT. (REC. S 11 1/2 E 18 5/ FT).

- 13" B. OAK NOW 18" WITH WELL HEALED DOUB. BLAZE BEARS N 1 1/2° W 28 2/ FT (REC. # 29 2/ FT).

✓ #200200(609)

C.S. File No. 67/26 - 18
C

RENEWAL

Monument Set (Procedure and Description)

NONE

Monument Detail

N/A

New Accessories

21" DIA. D. OAK DOUBLE BLAZED & SCRIBED "T 27S R4W S 30 CS BT" BEARS N 61° W 103± FT.

26" DIA. D. OAK DOUBLE BLAZED & SCRIBED "T 27S R4W S 32 CS BT" BEARS S 61° E 195± FT.

Sketch of Monument, Acessories, and General Area

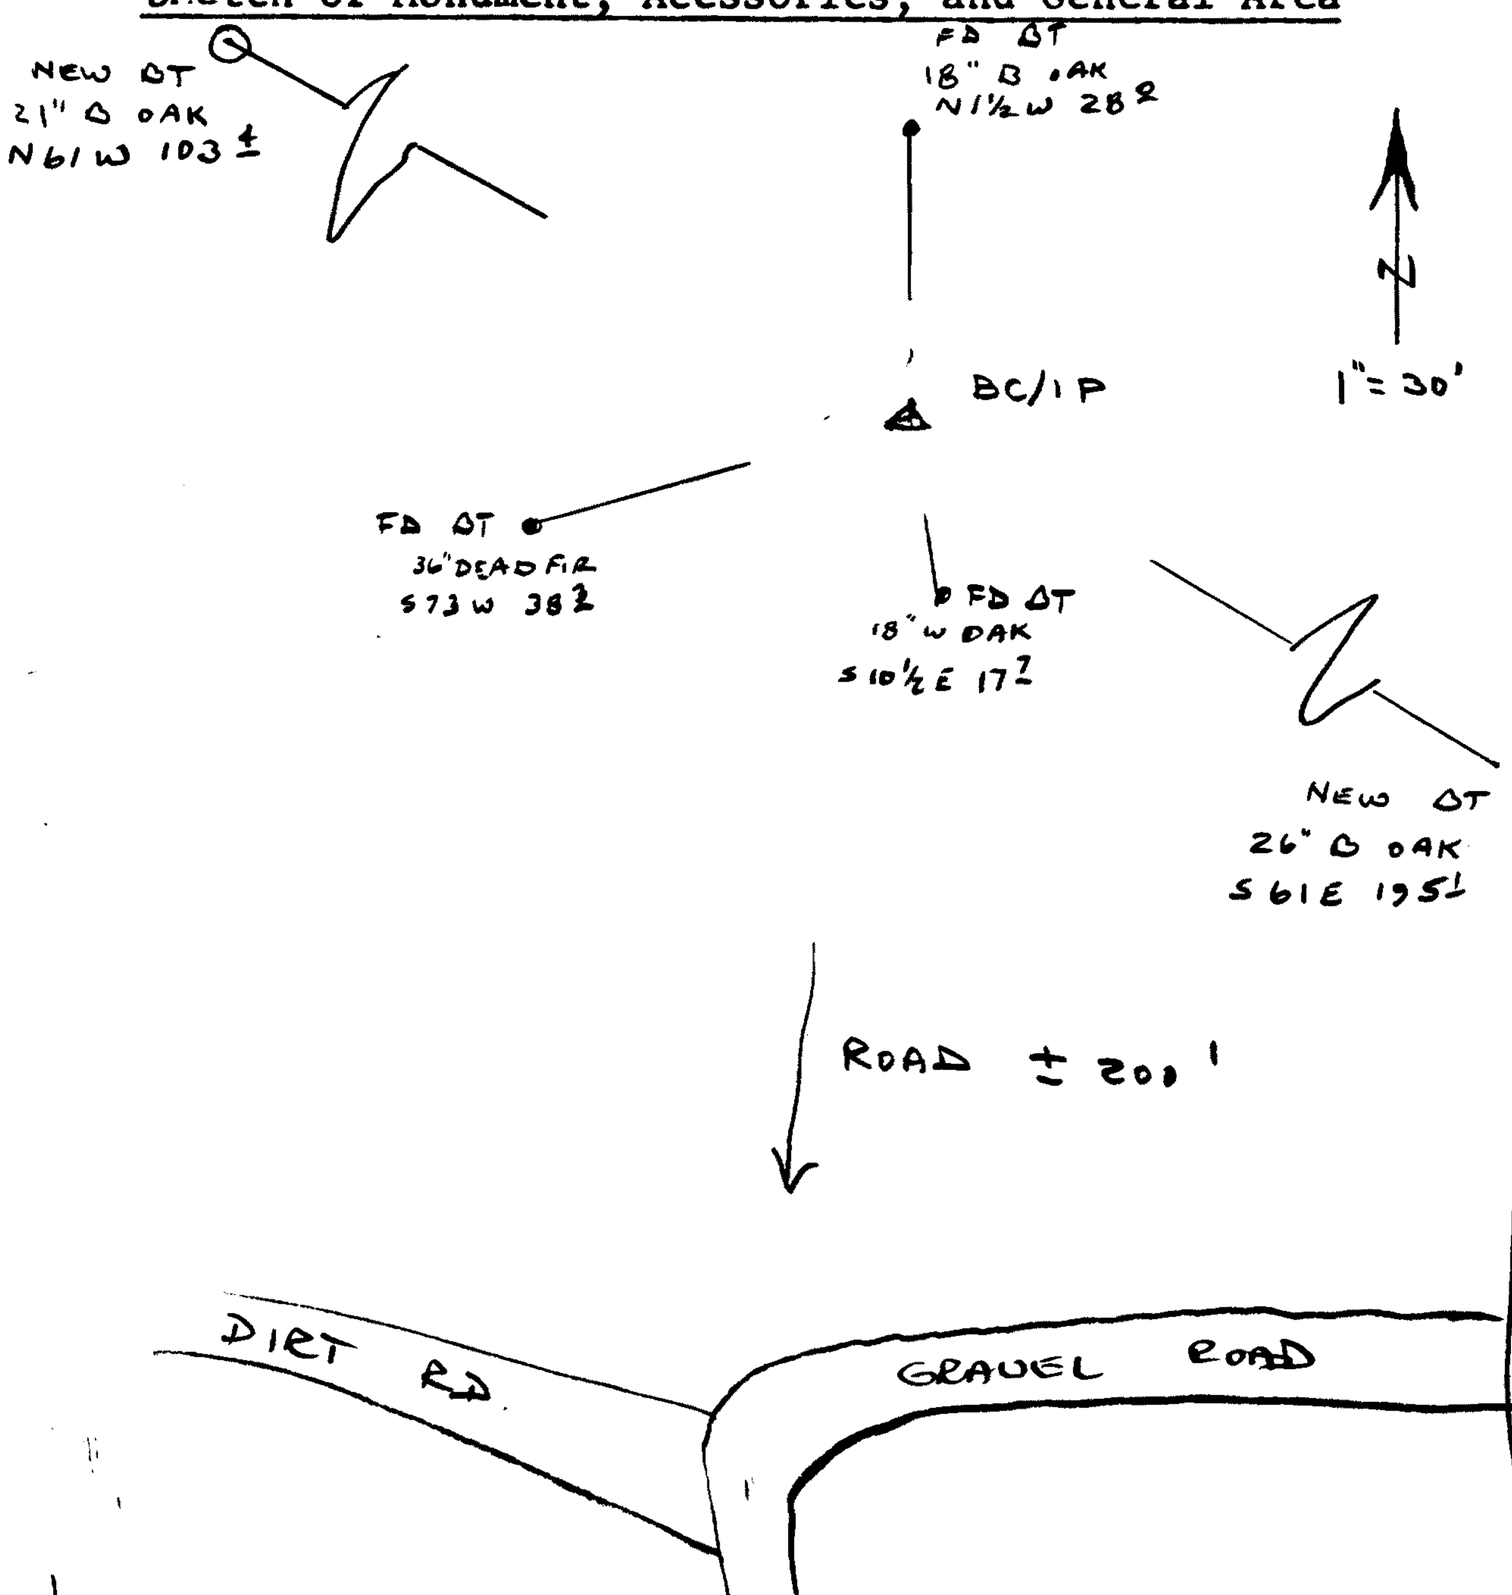

Location & Comments

Comp. Declin. 18° EAST
Agency DOUG. CO. SURV. OFF.
Party Chief MONREAN
Notekeeper "
Witnesses J. PIKE

Address RM 205 JUSTICE BLDG.
ROSEB. OR. 97470

Surveyor's Seal

REGISTERED
PROFESSIONAL
LAND SURVEYOR

Larry E. M

OREGON
JULY 13, 1979
LARRY E. MONREAN
#1830