R

FILED JP

GOVERNMENT CORNER RESTORATION FORM

Township 27S Range 7W Sec. 31 County DOUGLAS MAY 6 1993

State OR Date 3-30-93 No. COUNTY SURVEYOR DOUGLAS COUNTY, ORE.

Corner Designation

NORTH
WIT COR

1/4 S31 | S32

____ Condition Report Only
____ Not Found
✓ Renewed
____ Unrecorded
____ Surveyed In
____ Referenced Out

Previous Renewals #29 #60 #79

Monument(s) Found: (Condition and Source)

2½" DIA. DCSO BRASS CAP ON A 1½" O.D. IRON PIPE, PROTRUDING 8" ABOVE GROUND. (REN #79)

MONUMENT DETAIL

COUNTY SURVEYORS OFFICE
T27S R7W
WIT. COR.
150' TO SOUTH
S31 | 1/4 COR. S32
1960

Accessories Found:

~~NONE~~ NO BT'S RECORDED IN REN #79

200140 C

C.S. File No. 64/43

RENEWAL

Monument Set (Procedure and Description)

NONE

Monument Detail

N/A

New Accessories

A TRIPLE TRUNKED ASH, DOUBLE BLAZED AND SCRIBED "WC 1/4 S32 CS BT" ON 12" DIA NORTH WEST TRUNK, ROOT CROWN BEARS S 47° E, 11.8 FT

MOST NORTHERLY FENCE CORNER OF BPA SUB STATION, BEARS S 8 1/4° E, 94.8 FT

BPA POWER POLE "RF1 11 A" BEARS S 70 1/2° W, 161.6 FT

Sketch of Monument, Acessories, and General Area

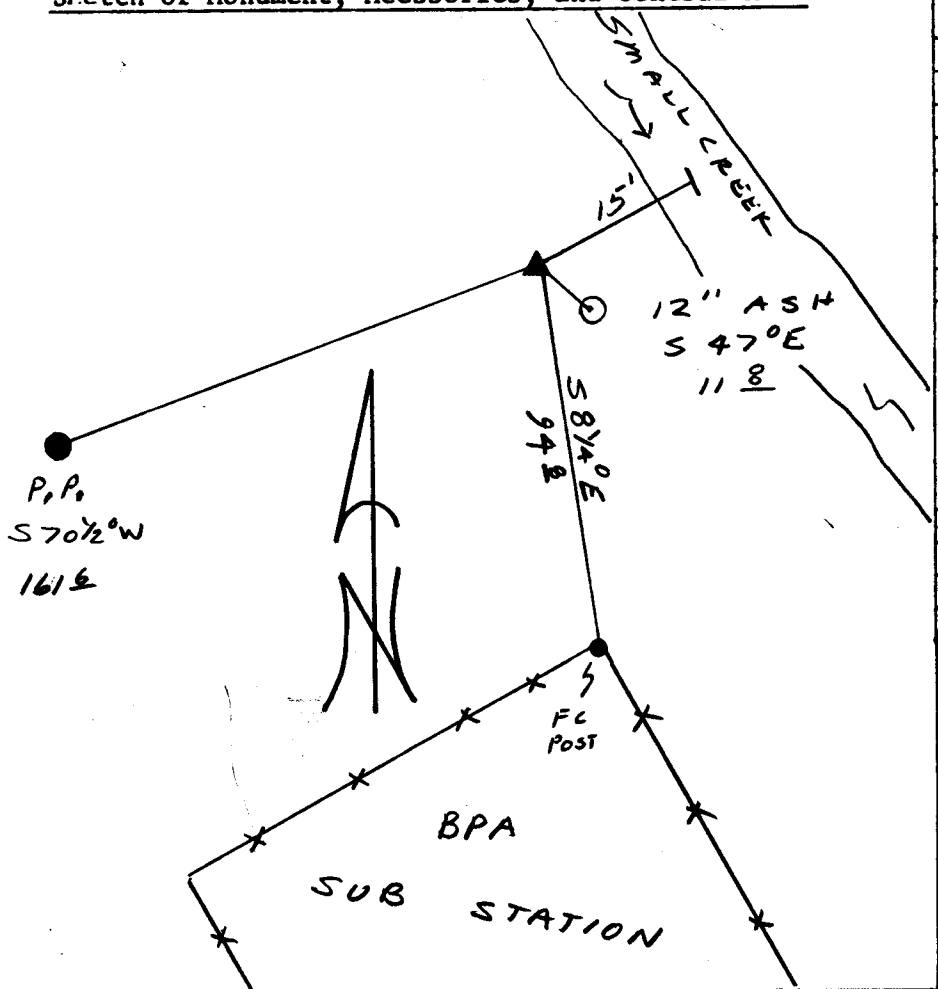

Location & Comments

CORNER LIES APPROX 15 FT SOUTH WEST OF SOUTH EAST RUNNING CREEK 4 FT FROM TOP OF SOUTHERLY BANK.

Comp. Declin. 18°E
Agency OCSO
Party Chief RANDALL W SMITH
Notekeeper Randall W Smith
Witnesses STEPHEN J FLAVSE

Address

Surveyor's Seal

REGISTERED
PROFESSIONAL
LAND SURVEYOR

Randall W Smith
EXPIRES 12-31-94

OREGON
JULY 25, 1990
RANDALL W. SMITH
2469