R

FILED JP

GOVERNMENT CORNER RESTORATION FORM

Township 27S Range 6W Sec. 36 County DOUGLAS

AUG 2 5 1993

State OR Date 7-20-93 No.

COUNTY SURVEYOR
DOUGLAS COUNTY, ORE.

Corner Designation

S¼ S.36
ONLY

P1 # 640100

Previous Renewals 1964 GODFREY

Monument(s) Found: (Condition and Source)

2½" DIA BRASS CAP ON A 1¼" O.D. IRON PIPE PROTRUDING 14" ABOVE GROUND. (1964 GODFREY)

____ Condition Report Only
____ Not Found
✓ Renewed
____ Unrecorded
____ Surveyed In
____ Referenced Out

MONUMENT DETAIL

COUNTY SURVEYORS OFFICE
T 27S
R 6W
S ¼ 36
1964

Accessories Found:

12" NOW 12" DIA DEAD OAK WITH A PREVIOUSLY OPENED BLAZE, REVERSE SCRIBING FOUND, BEARS N11°W 30.4 FT (AGREES WITH REC.) ORIG. BT

13" NOW 16" DIA B. OAK WITH A FULLY HEALED SINGLE BLAZE, BEARS N50°E, 34.9 FT (AGREES WITH REC) 1964 GODFREY

17" NOW 19" DIA B. OAK WITH A FULLY HEALED DOUBLE BLAZE, BEARS N77°E, 25.5 FT (AGREES WITH REC) 1964 GODFREY

27-6 640100 C
20-6 631700

C.S. File No. 64/46-3

RENEWAL

Monument Set (Procedure and Description)

NONE

Monument Detail

N/A

New Accessories

7" DIA. W. OAK DOUBLE BLAZED AND SCRIBED "Y4S36 CS BT"
BEARS N 10½°E, 39.8 FT.

11" DIA B. OAK DOUBLE BLAZED AND SCRIBED "Y4S36 CS BT"
BEARS N 63°W, 29.2 FT

Sketch of Monument, Acessories, and General Area

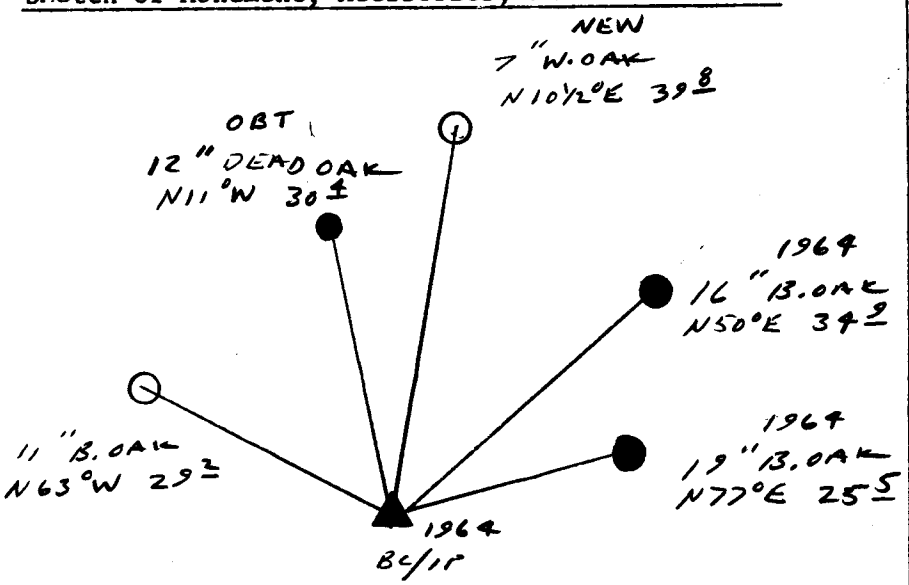


Location & Comments

Comp. Declin. 18°E
Agency DCSO
Party Chief RANDALL W. SMITH
Notekeeper Randall W Smith
Witnesses

Address

Surveyor's Seal

REGISTERED
PROFESSIONAL
LAND SURVEYOR

Randall W Smith
EXPIRES 12-31-94

OREGON
JULY 25, 1990
RANDALL W. SMITH
2469