R

GOVERNMENT CORNER RESTORATION FORM

FILED BC

NOV 16 1993

COUNTY SURVEYOR
DOUGLAS COUNTY, OREGON

Township 28S Range 7W Sec. 28 County DOUGLAS

State OR Date 9-29-93 No.

Corner Designation

SW COR
DLC 51

___ Condition Report Only
___ Not Found
✓ Renewed
___ Unrecorded
___ Surveyed In
___ Referenced Out

Previous Renewals VOL. 1 pg 1, DCSO 1946, DCSO 1969

Monument(s) Found: (Condition and Source)

A 2½" DIA. DCSO BRASS CAP ON
A 1⅜" O.D. IRON PIPE PROTRUDING
8" ABOVE GROUND 1969 DCSO

MONUMENT DETAIL

COUNTY SURVEYORS OFFICE
T 28S
S.W. COR.
D.L.C. 51
R 7W
1969

Accessories Found:

ORIG BT GONE

50" FIR (N20°W 3.0FT) GONE VOL 1 pg 1

12" W. FIR (S65°47'E 17.7F) GONE DCSO 1946

12" NOW 26" DIA. W. FIR WITH A FULLY HEALED DOUBLE BLAZE, BEARS N67¼°E, 31.2 FT (AGREES WITH REC) DCSO 1946

5" NOW 14" DIA. D. FIR WITH A FULLY HEALED DOUBLE BLAZE BEARS N12°W, 28.3 FT (AGREES WITH REC) DCSO 1969

051030 ✓

C.S. File No. 64/47-8 C

RENEWAL

Monument Set (Procedure and Description)

NONE

Monument Detail

N/A

New Accessories

3½" DIA. BLM BRASS CAP ON A 2½" O.D. IRON PIPE, PROTRUDING 5" ABOVE GROUND MARKED "T 28S R7W C51 S28 C53 1993"
BEARS EAST, 26.4 FT

9" DIA W. FIR DOUBLE BLAZED AND SCRIBED "SW DLC 51 CS BT"
BEARS N36°E, 8.0 FT

Sketch of Monument, Acessories, and General Area

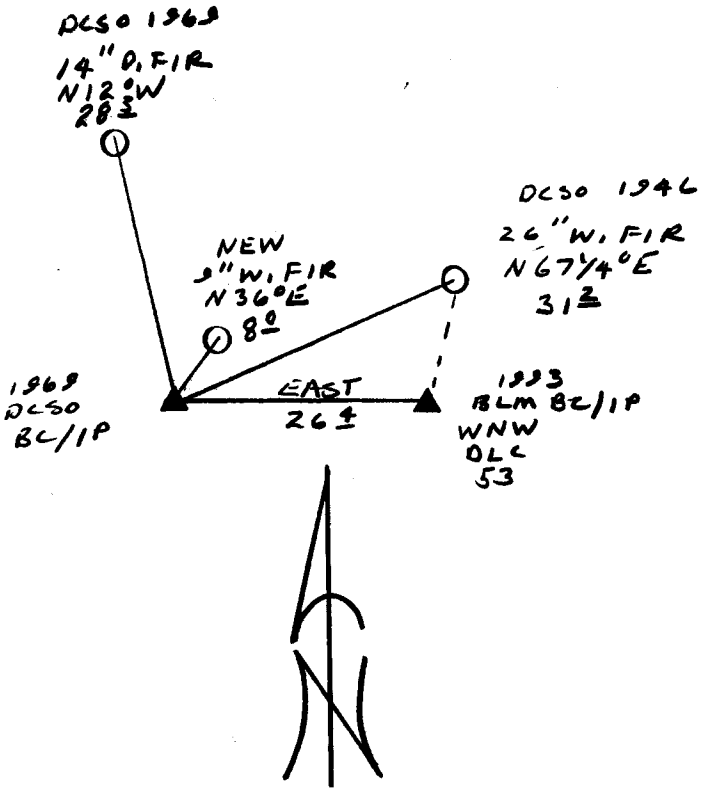

Location & Comments

Comp. Declin. 18°E
Agency DCSO
Party Chief RANDALL W SMITH
Notekeeper Randall W Smith
Witnesses STEPHEN J FLAUSE

Address

Surveyor's Seal

REGISTERED
PROFESSIONAL
LAND SURVEYOR

Randall W. Smith
EXPIRES 12-31-94

OREGON
JULY 25, 1990
RANDALL W. SMITH
2489