R

FILED

GOVERNMENT CORNER RESTORATION FORM

Date: 3-15-94 By: JC

Township 27S Range 4W Sec. 6 County DOUGLAS

This survey consists of:
Map:
Narrative:
Corner Rpt: CS 64/50

State OR Date 2-7-94 No.

Corner Designation

1/4 S1 | S6

DOUGLAS COUNTY SURVEYOR

___ Condition Report Only
___ Not Found
✓ Renewed
___ Unrecorded
___ Surveyed In
___ Referenced Out

Previous Renewals 1964 GODFREY P1 #700640

MONUMENT DETAIL

Monument(s) Found: (Condition and Source)
2 1/2" DIA BRASS CAP ON A 1 1/4" O.D. IRON PIPE PROTRUDING 9" ABOVE GROUND. 1967

COUNTY SURVEYORS OFFICE
T 27S

1/4 R 5 W	S 1	S 6	R 4 W

1964

Accessories Found:
20" NOW 26" DIA. 3 FT HIGH BURNT OAK STUMP WITH SCRIBE MARKS VISIBLE "BT" BEARS S 55°E, 92.4 FT (REC. S 53°E, 92.4) OBT

8" NOW [redacted]" DIA W. OAK WITH A FULLY HEALED DOUBLE BLAZE, BEARS N 81°W, 22.5 FT (AGREES WITH REC.) 1964

8" NOW [redacted]" DIA. W. OAK WITH A FULLY HEALED DOUBLE BLAZE, BEARS S 75°E, 28.6 FT (AGREES WITH REC.) 1964

ORIG NW BT NOW GONE.

✓T27-4 100640
✓T27-5 700640 C.S. File No. 64/50-C

RENEWAL

Monument Set (Procedure and Description)

NONE

Monument Detail

N/A

New Accessories

19" DIA. W. OAK DOUBLE BLAZED AND SCRIBED "Y4S6 CS BT"
BEARS N 66½° E 56.6 FT.

17" DIA. W. OAK DOUBLE BLAZED AND SCRIBED "Y4S1 CS BT"
BEARS S 44½° W 23.7 FT.

Sketch of Monument, Acessories, and General Area

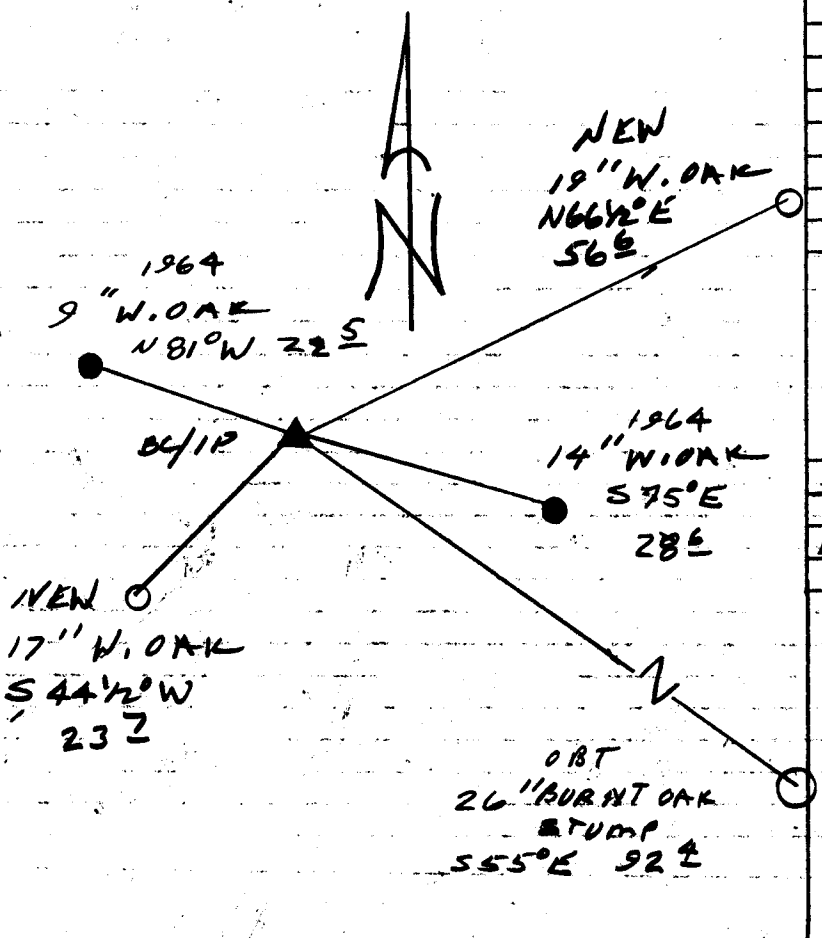

Location & Comments

Comp. Declin. 17¾° E
Agency DCS
Party Chief RANDALL W SMITH
Notekeeper [illegible]
Witnesses [illegible]

Address

Surveyor's Seal

REGISTERED
PROFESSIONAL
LAND SURVEYOR

Randall W. Smith
EXPIRES 12-31-94

OREGON
JULY 25, 1990
RANDALL W. SMITH
2469