FILED

Date: 3-15-94 By: JC

GOVERNMENT CORNER RESTORATION FORM

Township 27S Range 5W Sec. 10 County DOUGLAS

State OR Date 2-7-94 No.

This survey consists of:
Map:
Narrative:
Corner Rpt: C.S. 64/50

DOUGLAS COUNTY SURVEYOR

Condition Report Only
___ Not Found
✓ Renewed
___ Unrecorded
___ Surveyed In
___ Referenced Out

Corner Designation

1/4 S10 | S11

Previous Renewals 1967 BAUGHMAN

Monument(s) Found: (Condition and Source)

A 2½" DIA. BRASS CAP ON A 1¼" O.D. IRON PIPE PROTRUDES 2" ABOVE GROUND. 1967

MONUMENT DETAIL

T27S, R5W
1/4
S10 | S11

1967 O.L.S. 536

Accessories Found:

6" NOW 12" DIA DEAD MADRONE WITH A PREVIOUSLY OPENED BLAZE, SCRIBING APPEARS TO HAVE BEEN AXED OUT, BEARS N58°W, 28.8FT (REC N58°W, 29.4FT DIST POSSIBLE SLOPE MEASUREMENT) 1967

10" NOW 13" DIA. W. OAK WITH A FULLY HEALED DOUBLE BLAZE BEARS N64°E, 56.1FT (AGREES WITH RECORD) 1967

T27-S 500540

C.S. File No. 64/50

RENEWAL

Monument Set (Procedure and Description)

NONE

Monument Detail

N/A

New Accessories

9" DIA. MADRONE DOUBLE BLAZED AND SCRIBED "Y4S10CS BT" BEARS N54½°W, 104.1 FT.

13" DIA. DOUBLE TRUNKED MADRONE DOUBLE BLAZED AND SCRIBED "Y4S10CS BT" ON NE TRUNK BEARS S 13° W, 81.6 FT TO CENTER OF ~~NE~~ TRUNK.

8" DIA. D.FIR DOUBLE BLAZED AND SCRIBED "Y4S 11 CS BT" BEARS S 1½°E, 61.1 FT.

Sketch of Monument, Acessories, and General Area

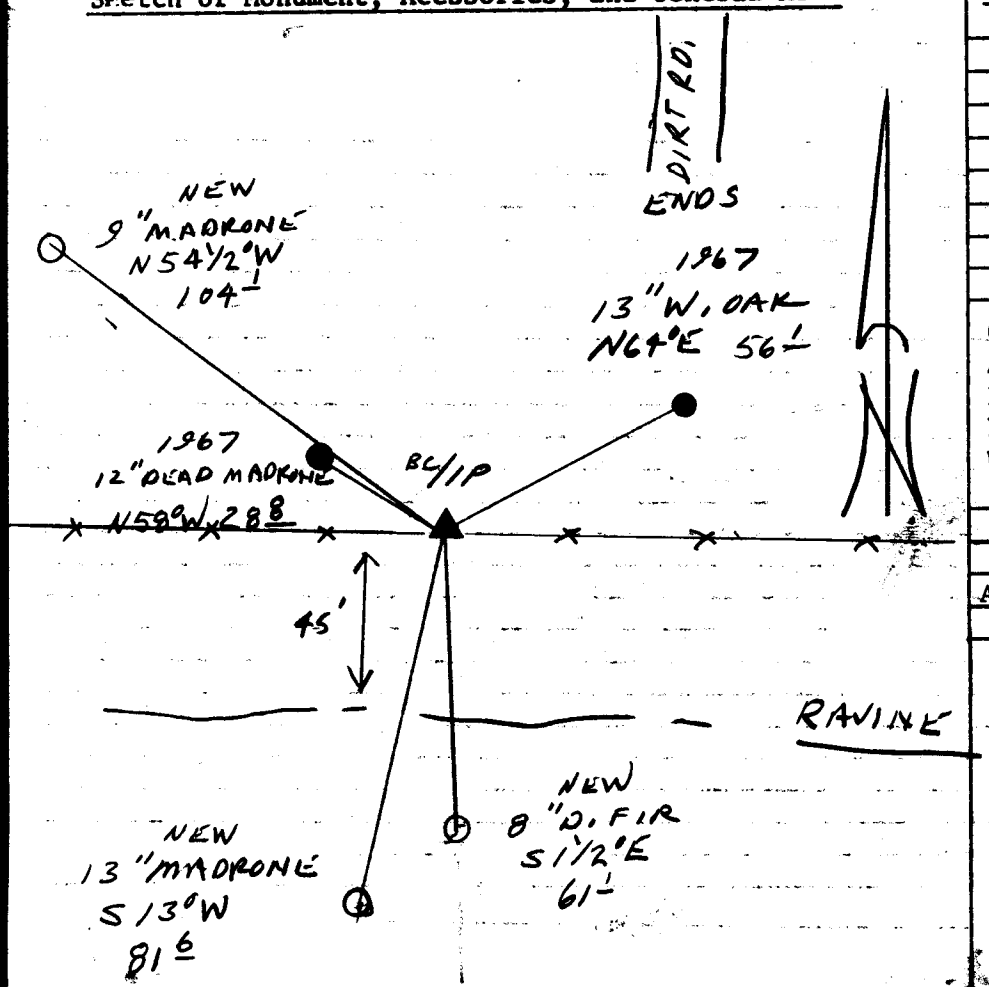

Location & Comments

CORNER LIES IN AN EAST-WEST FENCE LINE. 45 FT NORTH OF A EAST WEST RAVINE AND 60 FT SOUTHWEST OF THE END OF A DIRT ROAD.

Comp. Declin. 17¾°E
Agency DCSO
Party Chief RANDALL W. SMITH
Notekeeper Randall W. Smith
Witnesses STEPHENJ FLAUSE

Address

Surveyor's Seal

REGISTERED
PROFESSIONAL
LAND SURVEYOR

Randall W. Smith
EXPIRES 12/31/94

OREGON
JULY 25, 1990
RANDALL W. SMITH
2469