R

FILED

GOVERNMENT CORNER RESTORATION FORM

Date: 3-15-94 By: JC

This survey consists of:
Map:
Narrative:
Corner Rpt: C.S. 64/50

Township 27S Range 6W Sec. 24 County DOUGLAS

State OR Date 11-9-93 No.

Corner Designation

1/4 S 24 / S 25

P.I # 640300

DOUGLAS COUNTY SURVEYOR

___ Condition Only
___ Not Found
✓ Renewed
___ Unrecorded
___ Surveyed In
___ Referenced Out

Previous Renewals 1958 BYRON

Monument(s) Found: (Condition and Source)

2 1/2" DIA DCSO BRASS CAP ON A 1 1/4" O.D. IRON PIPE, PROTRUDING 3" ABOVE GROUND. (1958 BYRON)

MONUMENT DETAIL

COUNTY SURVEYORS OFFICE
T 27S
S 24
1/4
S 25
R 6W
1958

Accessories Found:

CHISLED 2"-"+" IN A CONCRETE CURB, BEARS N28°E, 2.0FT (AGREES WITH REC). 1958 BYRON

18" W. OAK BRG. S41°E 6.0 FROM 1958 BYRON RENEWAL IS GONE.

T 27-6 640300

C.S. File No. 64/50

X

RENEWAL

Monument Set (Procedure and Description)

NONE

Monument Detail

N/A

19.8
1.1
20.9

11 4
50 6
62

New Accessories

NORTH EAST CORNER OF HOUSE AT 1703 KENDALL ST BEARS S 4½°E, 20.9 FT

NORTH EAST CORNER OF A 10½' BY 16' CONCRETE SLAB BEARS S 67½°W, 17.0 FT

SOUTHWEST CORNER OF THE SOUTHWEST CARPORT SUPPORT POST AT 1683 KENDALL ST BEARS N 41°E, 62.0 FT

Sketch of Monument, Acessories, and General Area

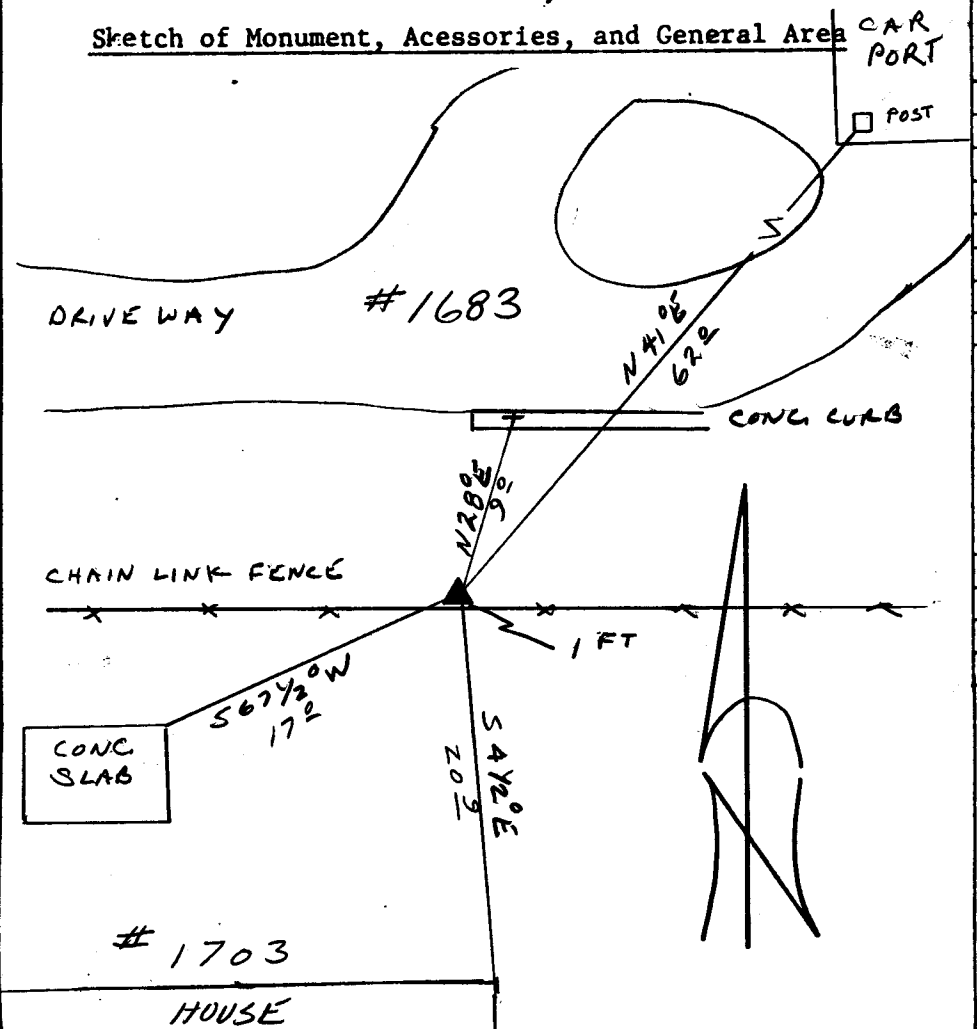

Location & Comments

CORNER LIES APPROX 170 FT EAST OF THE ℄ OF KENDALL ST. BETWEEN PROPERTIES AT 1703 AND 1683. 1 FT NORTH OF A EAST-WEST FENCE.

Comp. Declin. 18°E
Agency DCSO
Party Chief RANDALL W SMITH
Notekeeper Randall W Smith
Witnesses STEPHEN J FLAUSE

Address

Surveyor's Seal

REGISTERED
PROFESSIONAL
LAND SURVEYOR

Randall W Smith
EXPIRES 12-31-94

OREGON
JULY 25, 1990
RANDALL W. SMITH
2469