R

FILED

GOVERNMENT CORNER RESTORATION FORM

Date: 6/25/96 By: RC

Township 25S Range 7W Sec. 35 County DOUGLAS

This survey consists of:

Map: _____

Narrative: _____

Corner Plat: 64/69-8

State OK Date 6-20-96 No. _____

Corner Designation

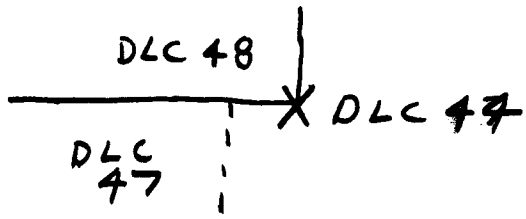


DOUGLAS COUNTY SURVEYOR

Condition Report Only

✓ Not Found

Renewed

Unrecorded

Surveyed In

Referenced Out

MONUMENT DETAIL

Previous Renewals 1913 FB 61 Pg 55 #044030

Monument(s) Found: (Condition and Source)

NONE

N/A

Accessories Found:

NONE

C.S. File No. 64/69-8

044030

**RENEWAL**

Monument Set (Procedure and Description)

NONE

Monument Detail

N/A

New Accessories

NONE

Sketch of Monument, Acessories, and General Area

N/A

Location & Comments

CREEK CALLED OUT IN DLC LINE NOTES APPEARS TO HAVE WIDENED OUT ON EAST BANK.

Comp. Declin. 17 3/4° E

Agency DLSO

Party Chief RANDALL W. SMITH

Notekeeper [signature]

Witnesses STEPHEN J FLAUGE

Address

Surveyor's Seal

REGISTERED PROFESSIONAL LAND SURVEYOR

[signature]

EXPIRES 6-30-96

OREGON JULY 25, 1990 RANDALL W. SMITH 2469

2)