

GOVERNMENT CORNER RESTORATION FORM

Date: 7/16/96 By: PC

Township 285 Range 7W Sec. _____

County DOUGLAS

This survey consists of:

State OR

Date 7-9-96

No. _____

Narrative: _____

Corner Rpt: CS 64/69-9

Corner Designation

WSW
DLC 49

DOUGLAS COUNTY

Condition: Renewed

Not Found

Renewed

Unrecorded

Surveyed In

Referenced Out

MONUMENT DETAIL

P1# 049030

Previous Renewals 1922 STEWART, 1958 & 1968 DCSO

Monument(s) Found: (Condition and Source)
2 1/2" DIA. BRASS CAP ON A 1 1/2" O.D.
IRON PIPE PROTRUDING 15" ABOVE
GROUND. (1958 DCSO)

COUNTY SURVEYORS OFFICE

T285 R7W

S.W. EXT. L,

D.L.C. 49

1958

CORNER STONE, PORTION ABOVE
GROUND MEASURES 4" X 3" X 2"
ABOVE GROUND. STONE IS ALONG
SOUTHERLY EDGE OF BC/IP.
(1922 STEWART)

Accessories Found:

12" NOW 16" DIA 3 FT HIGH ROTTED D.FIR STUMP
WITH ILLEGIBLE SCRIBING VISIBLE ON A PREVIOUSLY
OPENED BLAZE BEARS, N 72 1/2° E, 33.5 FT (REC N 75 1/2° E)
33.0 FT) 1922 STEWART

12" NOW 16" DIA 3 1/2 FT HIGH ROTTED D.FIR STUMP
WITH SCRIBING VISIBLE "C 6 49 BT" ON A PREVIOUSLY
OPENED BLAZE, BEARS N 32° E, 64.5 FT (AGREES
WITH RECORD) 1922 STEWART

14" NOW 14" DIA 2 FT HIGH ROTTED D.FIR STUMP
WITH SCRIBING VISIBLE "BT" ON A PREVIOUSLY
OPENED BLAZE, BEARS N 7° E, 5.2 FT (AGREES WITH RECORD)
1958 DCSO

14" DIA PINE NOW 23" DIA. T. CLEAR WITH A FULLY HEALED
DOUBLE BLAZE AND ATTACHED BT TAG BEARS S 44° E 9.3 FT
NOTE: SPECIES OF BT WRONG (BRG + DIST AGREE WITH RECORD)
1958 DCSO

7" NOW 8" DIA W. OAK WITH A FULLY HEALED SINGLE
BLAZE, BEARS N 81° E, 9.1 FT (AGREES WITH RECORD)
1968 DCSO

NEW
5/8" IRON ROD (S.H.R.W.) W/ TIE TO CORNER BEARS
S 16 1/2° E, 60.93 FT.

U.S. File No. 64/69-9

THESE CORNER ACCESSORIES
WILL BE GONE, CLEARED BY
NEW ROAD CONSTRUCTION.

RENEWAL

Monument Detail

Monument Set (Procedure and Description)

BC/IP AND STONE ARE REMOVED AND RESET AT A REFERENCE POSITION. BC/IP MEASURES 36" LONG, STONE MEASURES 5" X 8" X 12". THE STAMPING "1996 589W 150 FT" ARE ADDED TO BC.

BC/IP PROTRUDES 9" ABOVE GROUND. STONE IS SET ALONG NORTHERLY EDGE OF BC/IP PROTRUDES 4" ABOVE GROUND.

BC/IP IS SET N 89° E, 150 FT FROM CORNER

COUNTY SURVEYORS OFFICE
1996
T 28 S R 7 W

S.W. EXT. LI
D.L.C. 49

589 W 150 FT
1958

New Accessories ARE TO REFERENCE POINT (BC/IP)

- 5/8" I.R. (S.H.R.W.) BEARS S 65 1/4° W, 145.86 FT
- 9" DIA. MAPLE DOUBLE BLAZED AND SCRIBED "RP WSW DLC 49 CS BT" BEARS N 15 1/2° E, 35.0 FT
- DOUBLE TRUNKED MAPLE DOUBLE BLAZED AND SCRIBED "RP WSW DLC 49 CS BT" ON 8" DIA. EASTERLY TRUNK BEARS N 75 1/2° W, 32.4 FT TO CENTER BASE OF EASTERLY TRUNK.
- 6" DIA. D.FIR DOUBLE BLAZED AND SCRIBED "RP WSW DLC 49 CS BT" BEARS N 67 1/2° E, 11.0 FT.

Sketch of Monument, Accessories, and General Area

Location & Comments

AREA AROUND CORNER IS TO BE CLEARED FOR NEW ROAD CONSTRUCTION. BC/IP AND STONE ARE NOW REFERENCE POINTS TO ORIGINAL CORNER POSITION.

Comp. Declin. 17 3/4° E
Agency DCSO
Party Chief RANDALL W. SMITH
Notekeeper
Witnesses STEPHEN J. FLAUSK

Address


Surveyor's Seal

REGISTERED
PROFESSIONAL
LAND SURVEYOR

Randall W. Smith
6-30-98 EXPIRES

OREGON
JULY 25, 1990
RANDALL W. SMITH
2469

SKETCH

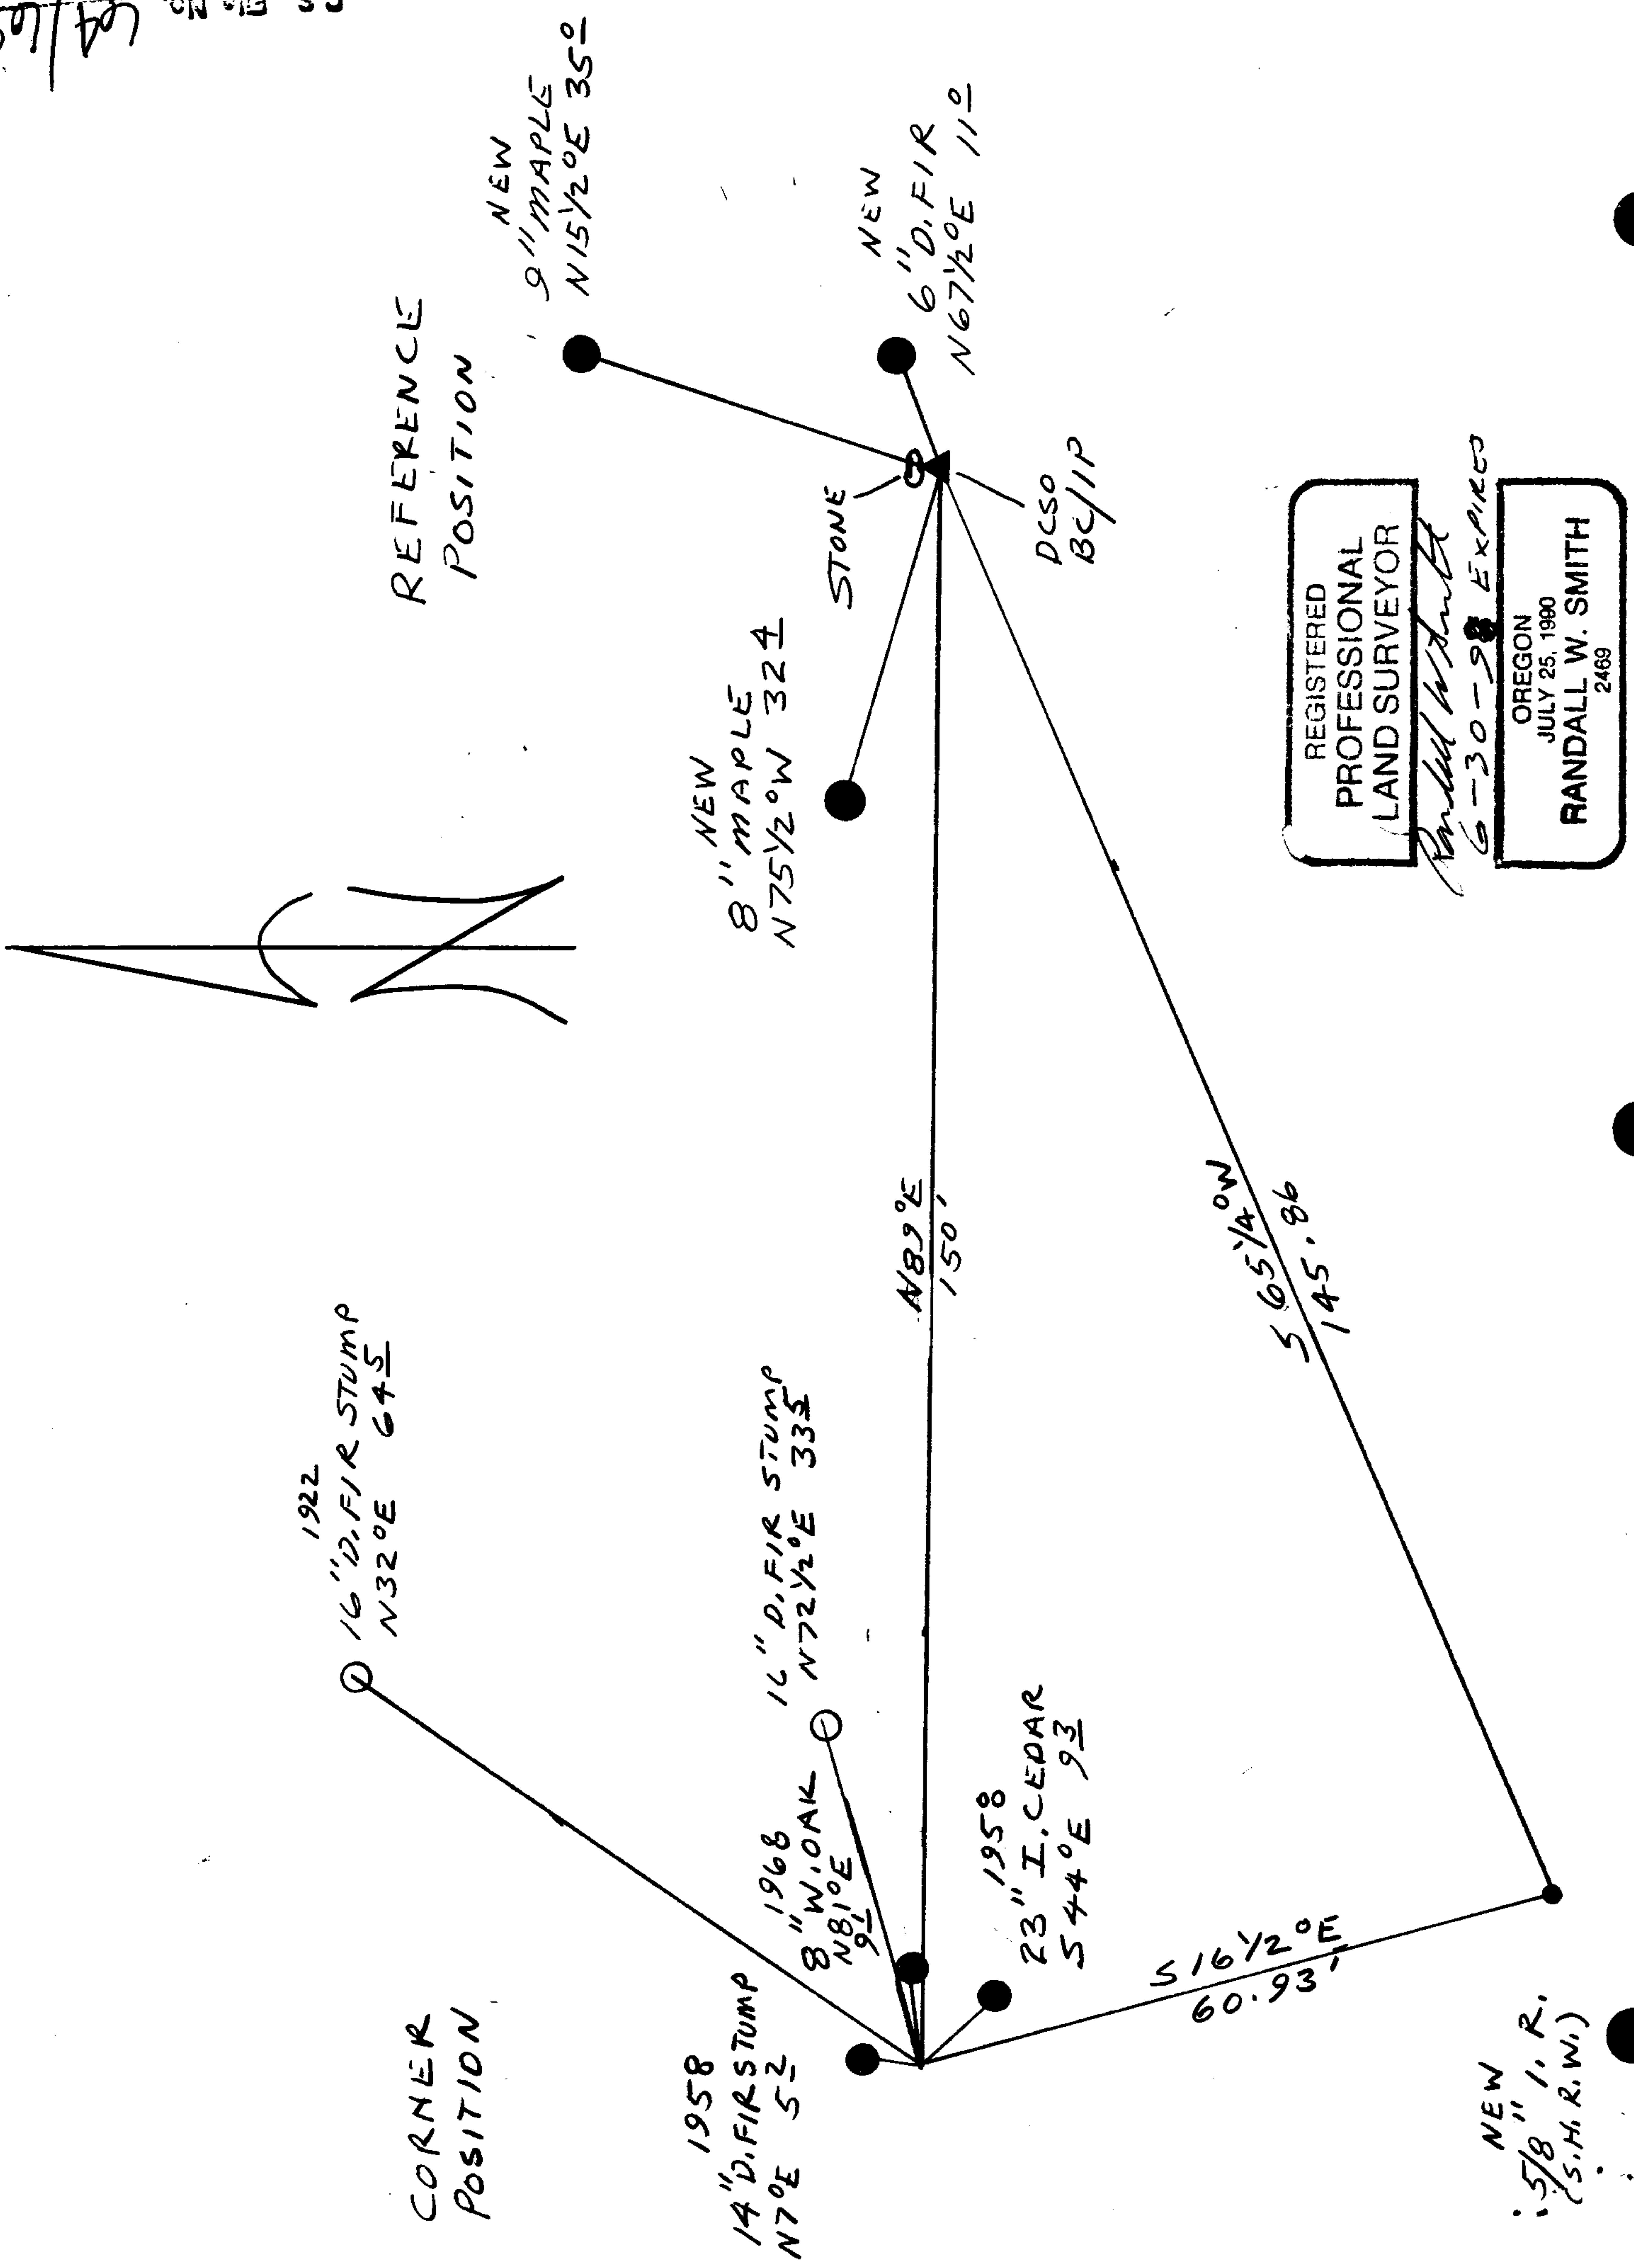

1922
16" D. FIR STUMP
N32°E 64.5'

CORNER
POSITION

1958
14" D. FIR STUMP
N7°E 5.2'

1968
8" W. OAK
N81°E 9.1'

16" D. FIR STUMP
N72 1/2°E 33.5'

1958
23" I. CEDAR
S44°E 9.3'

N89°E
150'

S16 1/2°E
60.93'

S65 1/4°W
145.86'

NEW
8" MAPLE
N75 1/2°W 32.4'

STONE

DCSO
BC/1P

NEW
6" D. FIR
N67 1/2°E 11.0'

REFERENCE
POSITION

NEW
9" MAPLE
N15 1/2°E 35.0'

NEW
5/8" I. R.
(S.H. R.W.)

REGISTERED
PROFESSIONAL
LAND SURVEYOR

Randall W. Smith
6-30-98 EXPIRES

OREGON
JULY 25, 1980
RANDALL W. SMITH
2469