FILED

Date: 7.31.96 By: PoC

This survey consists of:

Map: _____

Narrative: _____

Corner Rpt: CS 64/69-12

GOVERNMENT CORNER RESTORATION FORM

Township 25S Range 7W Sec. 33 County DOUGLAS

State OR Date 7-8-96 No. _____

Corner Designation

S 33/S34

PI # 400140

Previous Renewals 1949 WOODFORD, 1968 BLM

DOUGLAS COUNTY SURVEYOR

___ Condition Report Only
___ Not Found
✓ Renewed
___ Unrecorded
___ Surveyed In
___ Referenced Out

Monument(s) Found: (Condition and Source)

3 1/4" DIA BRASS CAP ON A 2 1/2" O.D. IRON PIPE PROTRUDING 10" ABOVE GROUND. (1968 BLM)

1" DIA. AXLE WITH A 3" DIA GEAR PROTRUDING 10" ABOVE GROUND IS ALONG WESTERLY EDGE OF BC/IP. (1949 WOODFORD)

MONUMENT DETAIL

U.S. DEPT. OF THE INTERIOR

T 25S R7W

1/4

S33 | S34

1968

BUR. OF LAND MANAGEMENT

Accessories Found:

20" NOW 35" DIA. B. OAK WITH A FULLY HEALED DOUBLE BLAZE BEARS N 1°E, 59.4 FT (AGREES WITH 1968 BLM RECORD) 1949 WOODFORD.

12" NOW 31" DIA. B. OAK WITH A FULLY HEALED DOUBLE BLAZE BEARS N 24 3/4°W, [illegible] FT. (AGREES WITH 1968 BLM RECORD) 1949 WOODFORD.

✓ 400140

C.S. File No. 64/69-12

RENEWAL

Monument Set (Procedure and Description)

NONE

Monument Detail

N/A

New Accessories

20" DIA. D.FIR DOUBLE BLAZED AND SCRIBED "Y4 S34CS BT"
BEARS N 74½°E, 12.3 FT

17" DIA. D.FIR DOUBLE BLAZED AND SCRIBED "Y4S33CS BT"
BEARS N 11¾°W, 70.8 FT

Sketch of Monument, Acessories, and General Area

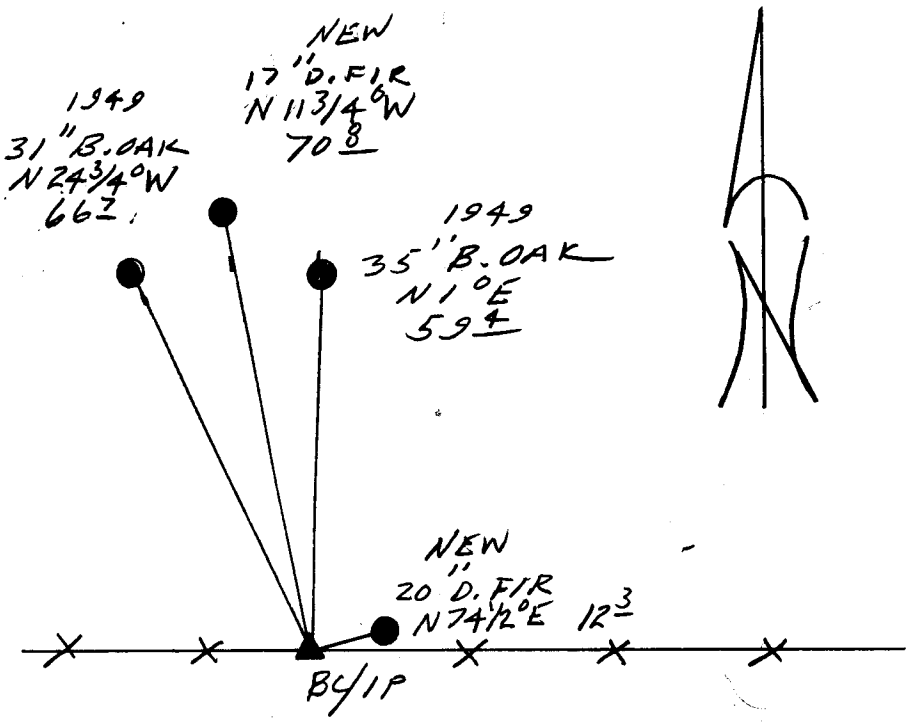

Location & Comments

CORNER LIES IN AN EAST — WEST FENCE LINE

Comp. Declin. 17¾°E
Agency DCSO
Party Chief RANDALL W SMITH
Notekeeper Randall W Smith
Witnesses STEPHEN J FLAUSE

Address

Surveyor's Seal

REGISTERED
PROFESSIONAL
LAND SURVEYOR

Randall W Smith
EXPIRES 6-30-98

OREGON
JULY 25, 1990
RANDALL W. SMITH
2469