R

FILED

GOVERNMENT CORNER RESTORATION FORM

Date: 5/13/97 By: PoC

Township 27S Range 7W Sec. 31 County DOUGLAS

This survey consists of:
Map:
Narrative:
Corner Rpt: CS 64/74-24

State OR Date 4-30-97 No.

Corner Designation

PER M1-73

C 1/4 S 31
1930 DCSO

DOUGLAS COUNTY SURVEYOR

Condition Report Only
___ Not Found
✓ Renewed
___ Unrecorded
___ Surveyed In
___ Referenced Out

Previous Renewals NONE

MONUMENT DETAIL

Monument(s) Found: (Condition and Source)
1/4" SQUARE TOP BOLT FD
FLUSH WITH GROUND IN
E — W FENCE LINE
(1930 DCSO)

N/A

Accessories Found:

5" NOW 19" DIA. W. OAK WITH A FULLY HEALED BLAZE, BEARS S 44 1/2° W, 9.0 FT (AGREES WITH REC.) 1930 NW BT FROM 1930 DCSO SURVEY NOW GONE.

M1-73 1930 DCSO
#9 DRIFT BOLT 1"x18"
18"-5" W.O. N29°W 20.5
5" W.O. S44 1/2°W 9.0

✓ 140140

C.S. File No. 64/74-24

RENEWAL

Monument Set (Procedure and Description)

NONE

Monument Detail

N/A

New Accessories

3" DIA. CEDAR DOUBLE BLAZED AND SCRIBED "XBT" BEARS N41°W, 2.5 FT

10" DIA W. OAK DOUBLE BLAZED AND SCRIBED "C 1/4 S 31 CS BT" BEARS S 28½° E, 21.0 FT

12" DIA. D. FIR DOUBLE BLAZED AND SCRIBED "C 1/4 S 31 CS BT" BEARS N1°E, 35.2 FT

Sketch of Monument, Acessories, and General Area

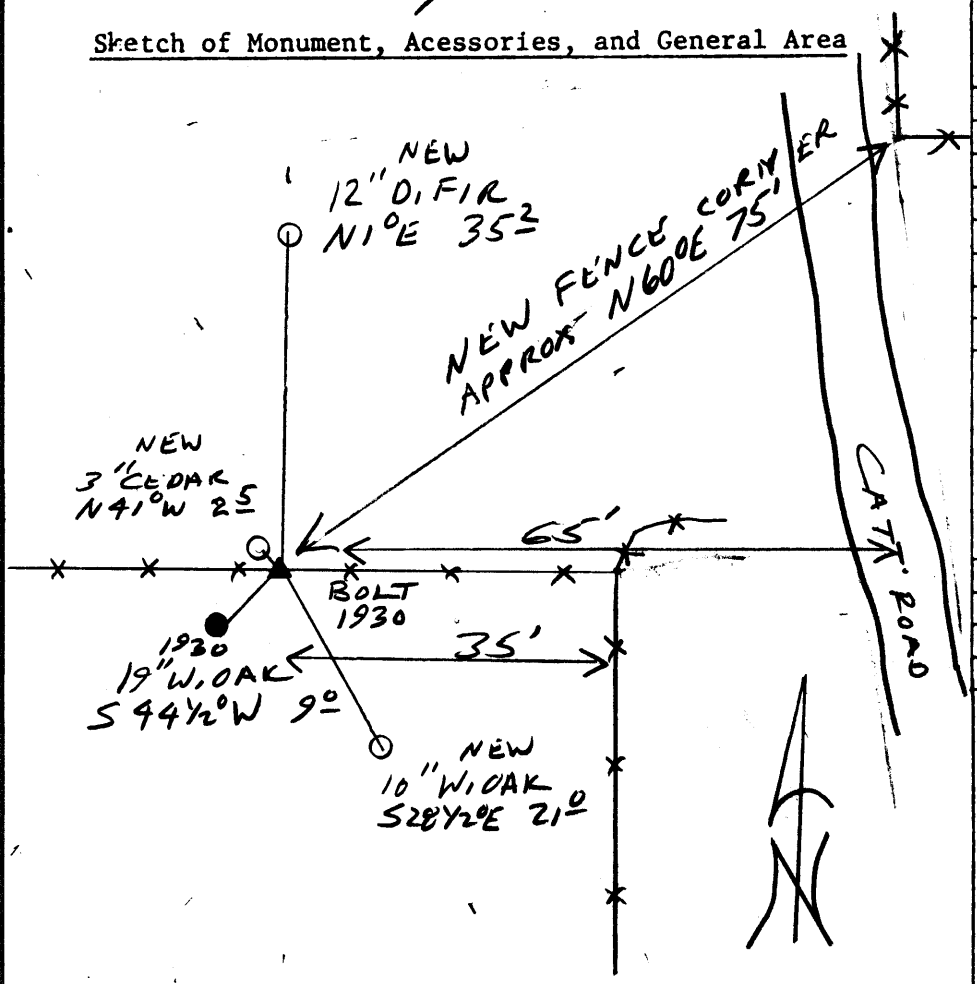

Location & Comments

CORNER IS IN AN OLD E-W FENCE LINE

NEW E-W'LY FC CORNER BRG N60°E 75'

CORNER LIES NEAR EAST EDGE OF 1 FT SQUARE BY 5 FT HIGH OAK POST

Comp. Declin. 17¾°E

Agency DCSO

Party Chief RANDALL W SMITH

Notekeeper [illegible]

Witnesses STEPHEN J FLAUSE

Address

Surveyor's Seal

REGISTERED PROFESSIONAL LAND SURVEYOR

Randall W. Smith

EXPIRES 6-30-98

OREGON
JULY 25, 1990
RANDALL W. SMITH
2469