R

FILED

GOVERNMENT CORNER RESTORATION FORM

Date: 5-13-1997 By: PC

Township 28S Range 7W Sec. 6 County DOUGLAS

This survey consists of:
Map:
Narrative:
Corner Rpt: CS 64/74-26

State OR Date 5-6-97 No.

Corner Designation

NW COR
SEC 6
ONLY

DOUGLAS COUNTY SURVEYOR

___ Corner Tie Only
___ Not Found
✓ Renewed
___ Unrecorded
___ Surveyed In
___ Referenced Out

PI # 902010

Previous Renewals 1924GLO, 1930DCSO M1-73

MONUMENT DETAIL

Monument(s) Found: (Condition and Source)

3½"DIA BRASS CAP ON A 3"O.D IRON PIPE PROTRUDES 6" ABOVE GROUND (1924)

U.S. GENERAL LAND

S6
R7W
T28S
1924

OFFICE SURVEY

Accessories Found:

10"NOW 28"DIA DOWN BROKEN ROTTED D.FIR SCRIBING FOUND "T28S R7W S6 BT" BEARS S8½°E, 71.1FT (AGREES WITH 1930 REC.) 1924

NOTE AN ERROR WAS MADE ON CORNER TIE TO ABOVE D.FIR PER SURVEY M1-73 AND 1930 CORNER RENEWAL A CHECK OF FIELD BOOK WAS MADE, BEARING SHOULD BE S8½°E THIS AGREES CLOSELY WITH 1924 GLO BEARING OF S8°E. RECORD S80½°E IS IN ERROR.

✓100700

C.S. File No. 64/74-26

RENEWAL

Monument Set (Procedure and Description)

NONE

Monument Detail

N/A

New Accessories

- NE CORNER OF BARN BEARS N 42°E, 22.8 FT
- 16" DIA W. OAK DOUBLE BLAZED AND SCRIBED "SCT28S R7W S6 CS BT" BEARS S13°W, 51.9 FT.
- 15" DIA. W. OAK DOUBLE BLAZED AND SCRIBED "SCT28S R7W S6 CS BT" BEARS N27½°W, 71.9 FT.
- 19" DIA. B. OAK DOUBLE BLAZED AND SCRIBED "SCT28S R7W S6 CS BT" BEARS N76°W, 82.0 FT.

Sketch of Monument, Acessories, and General Area

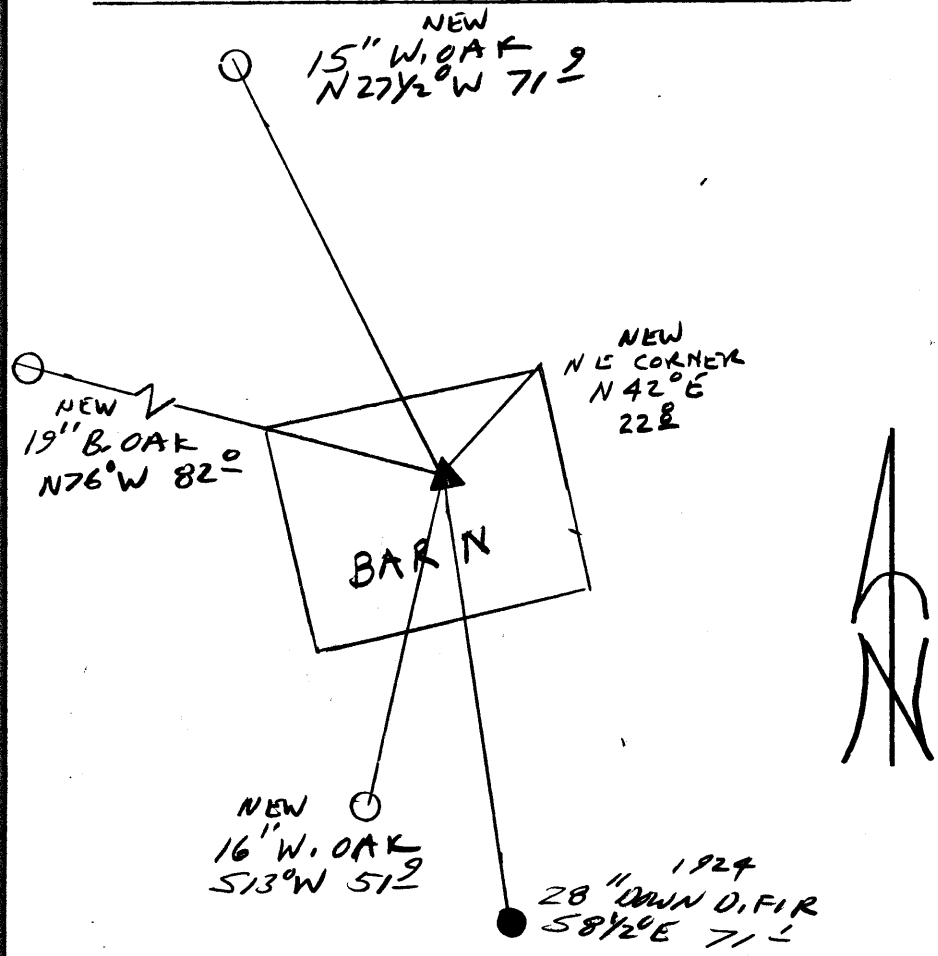

Location & Comments

CORNER IS LOCATED INSIDE A BARN

Comp. Declin. 17¾°E
Agency DCSO
Party Chief RANDALL W. SMITH
Notekeeper [illegible]
Witnesses STEPHEN J. FRANSEN

Address

Surveyor's Seal

REGISTERED PROFESSIONAL LAND SURVEYOR
[illegible]
EXPIRES 6-30-90
OREGON
JULY 25, 1990
RANDALL W. SMITH