FILED ✓

GOVERNMENT CORNER RESTORATION FORM

Date: 5-23-1997 By: PSC

This survey consists of:

Map: _____

Narrative: _____

Corner For: CS 64/74-34

DOUGLAS COUNTY SURVEYOR

Township 27S Range 8W Sec. 25 County DOUGLAS

State OR Date 5-19-97 No. _____

Corner Designation

526 | 525
535 | 536

____ Condition Report Only
____ Not Found
✓ Renewed
____ Unrecorded
____ Surveyed In
____ Referenced Out

Previous Renewals #26

MONUMENT DETAIL

Monument(s) Found: (Condition and Source)

2½" DIA. BRASS CAP ON A 1½" O.D. IRON PIPE, PROTRUDES 19" ABOVE GROUND (#26)

COUNTY SURVEYORS OFFICE
T27S R8W
526 | 525
535 | 536
1971

Accessories Found:

FROM REN #26
10" NDW 14" DIA 1½' HIGH BROKEN HEMLOCK STUMP WITH SCRIBING VISIBLE ON A PARTIALLY HEALED BLAZE "BT" BEARS N 81°W, 22.4FT (REC N 83°W, 22.4FT)

7" NDW 16" DIA W. FIR WITH A FULLY HEALED DOUBLE BLAZE, BEARS S 49°E, 18.0FT (REC S 47°E, 18.0FT)

8" NDW 14" DIA CEDAR WITH A FULLY HEALED DOUBLE BLAZE, BEARS S 45½°W, 19.7FT (REC. S 44°W, 19.7FT)

13" NDW 14" DIA 5½ FT HIGH HEMLOCK STUMP WITH SCRIBING VISIBLE OF AN OPEN BLAZE "T27S R8W S25CS" BEARS N 44½°E, 61.8FT (REC. N 46°E, 61.8FT)

THE ONLY REMAINING ORIGINAL BT IS A 24" NDW DOWN 36" DIA D. FIR WITH A PREVIOUSLY OPENED BLAZE ILLEGIBLE SCRIBING FOUND. ROOT HOLE AGREES WITH REC. "S 56½°W, 42.9FT". OBT

✓ # 84

C.S. File No. 64/74-34

RENEWAL

Monument Set (Procedure and Description)

BC/IP IS SURROUNDED BY A 1½ FT DIA MOUND OF STONE.

Monument Detail

N/A

New Accessories

10" DIA. D. FIR DOUBLE BLAZED AND SCRIBED "T27S R8W S26 CS BT" BEARS N74°W, 15.2 FT

15" DIA. D. FIR DOUBLE BLAZED AND SCRIBED "T27S R8W S25 CS BT" BEARS N79½°E, 15.4 FT

Sketch of Monument, Acessories, and General Area

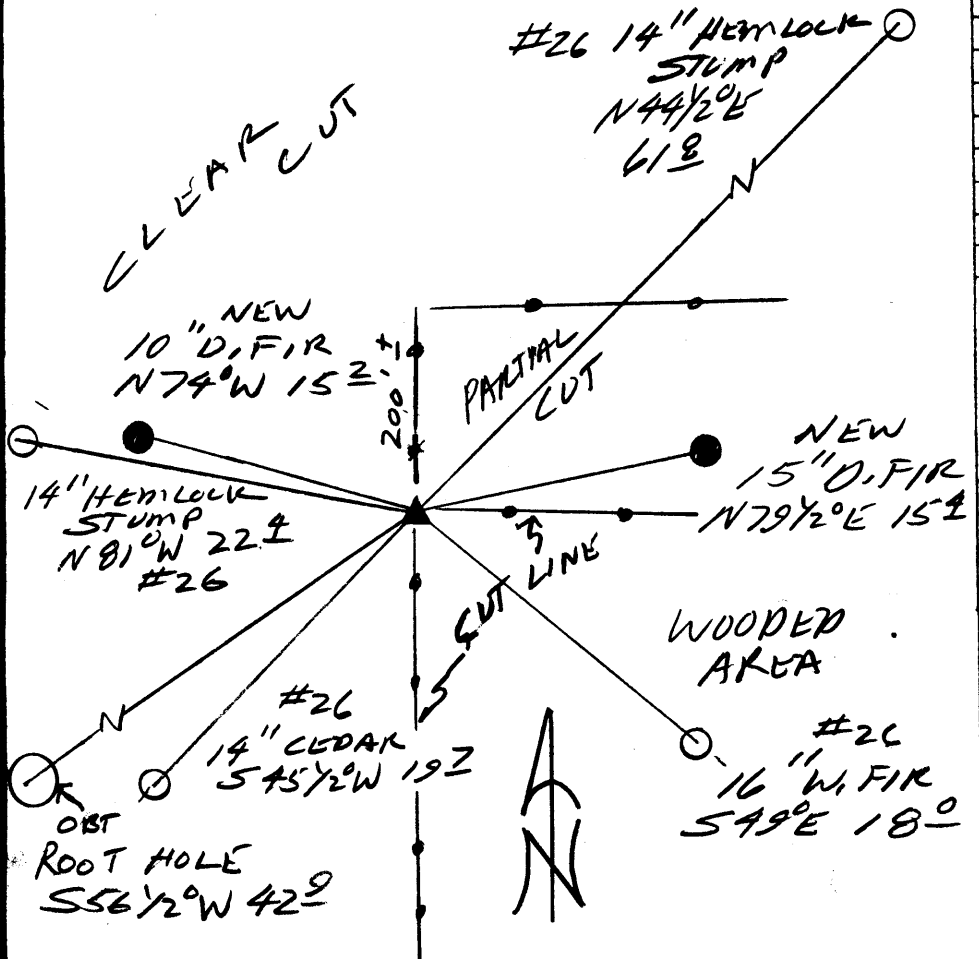

Location & Comments

Comp. Declin. 17¾°E
Agency DCSO
Party Chief RANDALL W. SMITH
Notekeeper [illegible]
Witnesses STEPHEN J. HAUSE

Address

Surveyor's Seal

REGISTERED PROFESSIONAL LAND SURVEYOR

[illegible] 6-30-98

OREGON JULY 25, 1980 RANDALL W. SMITH 2469