FILED

Date: 5.27.1997 By: RC

This survey consists of:

Map:

Narrative:

Corner Rpt: CS 64/74-36

GOVERNMENT CORNER RESTORATION FORM

Township 25S Range 5W Sec. 6 County DOUGLAS

State OR Date 5-20-97 No.

Corner Designation

1/4 S1/S6

DOUGLAS COUNTY SURVEYOR

___ Condition Report Only
___ Not Found
✓ Renewed
___ Unrecorded
___ Surveyed In
___ Referenced Out

Previous Renewals 1960 DCSO PI# 100640

Monument(s) Found: (Condition and Source)

2½" DIA. BRASS CAP ON A 1½" O.D. IRON PIPE PROTRUDES 14" ABOVE GROUND. (1960)

MONUMENT DETAIL

COUNTY SURVEYORS OFFICE

T25S R5W

R 6 W S1/S6 1/4

1960

Accessories Found:

18" NOW 30" DIA. DOWN AND ROTTED OAK SCRIBING FOUND "1/4" ROOT HOLE AGREES WITH REC. "N22½°W, 29.0 FT OBT ORIG NE BT NOW GONE.

10" NOW 16" DIA B. OAK WITH A FULLY HEALED DOUBLE BLAZE, BEARS N74°W 42.8 FT (AGREES WITH REC.) 1960 1960 SE BT NOW GONE.

100640

C.S. File No. 64/74-36

RENEWAL

Monument Set (Procedure and Description)

NONE

Monument Detail

N/A

New Accessories

24" DIA. W. OAK WITH AN OPEN HOLE NEAR BASE IS SINGLE BLAZE AND SCRIBED "1456 CS BT", BEARS S75½°E, 41.9 FT

11" DIA. D. FIR DOUBLE BLAZED AND SCRIBED "1451 CS BT" BEARS N63½°W, 15.5 FT.

5" DIA. W. OAK DOUBLE BLAZED AND SCRIBED "1451 CS BT" BEARS N23°W, 14.2 FT.

Sketch of Monument, Acessories, and General Area

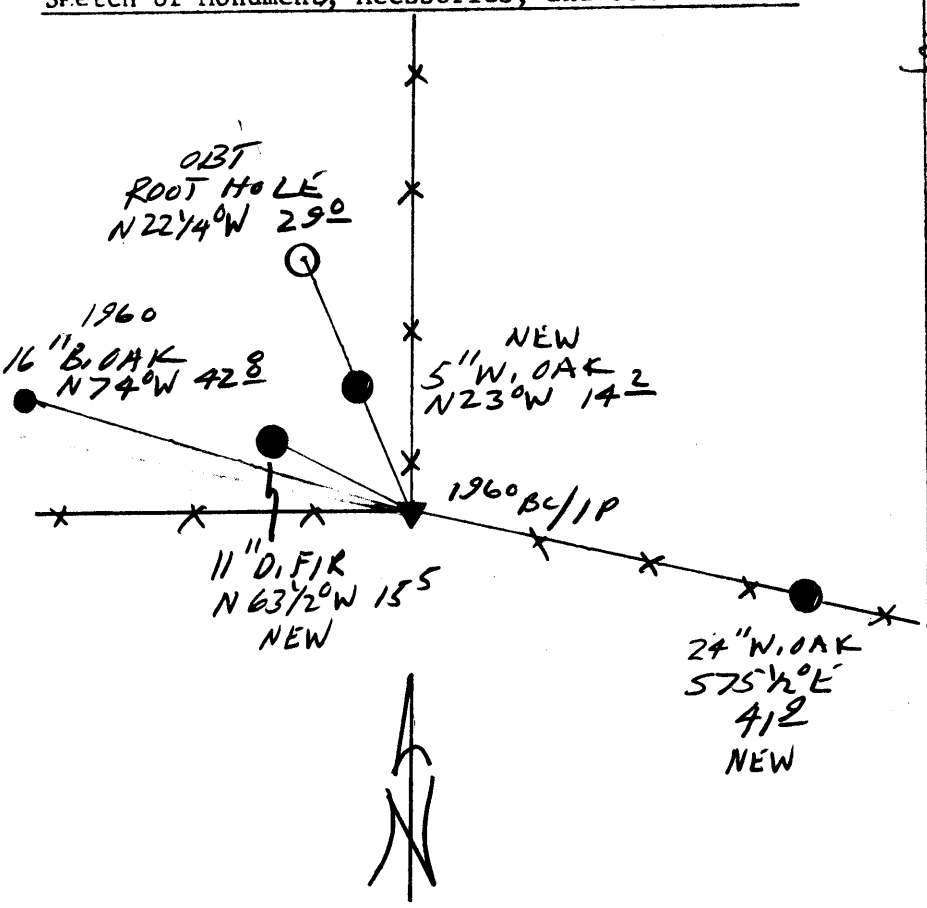

Location & Comments

CORNER LIES 1 FT. SOUTH OF A 3 WAY FENCE CORNER WITH FENCES RUNNING E-W. AND N.

Comp. Declin. 17¾°E

Agency DCSO

Party Chief RANDALL W. SMITH

Notekeeper [illegible]

Witnesses STEPHEN J. BARBE

Address

Surveyor's Seal

REGISTERED PROFESSIONAL LAND SURVEYOR

Randall W. Smith

EXPIRES 6-30-98

OREGON
JULY 25, 1990
RANDALL W. SMITH
2469