FILED

Date: 6/5/97 By: BC

This survey consists of:

Map:

Narrative:

Comp. Sht: CS 64/74-38

GOVERNMENT CORNER RESTORATION FORM

Township 27S Range 6W Sec. 23 County DOUGLAS

State OR Date 5-14-97 No.

Corner Designation

DLC 53

DOUGLAS COUNTY SURVEYOR

___ Condition Report Only
___ Not Found
✓ Renewed
___ Unrecorded
___ Surveyed In
___ Referenced Out

PI # 053070

Previous Renewals 1950, 1955 + 1974 DCSO

Monument(s) Found: (Condition and Source)

2½" DIA BRASS CAP ON A 1½" OD IRON PIPE PROTRUDES 3" ABOVE GROUND

MONUMENT DETAIL

COUNTY SURVEYOR'S

SW

DLC 53

OFFICE

NOTE! CAP ORRIENTATED SOUTH

Accessories Found:

10" NOW 15" DIA B. OAK WITH A FULLY HEALED DOUBLE BLAZE, BEARS S 4½°E, 120.5 FT (REC / S 43°E, 118.7 FT) 1955 DCSO

NW WT FROM 1955 REN. NOW GONE

NW CORNER OF CITY OF ROSEBURG SMALL BLOCK BUILDING BEARS S 89°E, 31.45 FT (REC S 86½°E 31.45 FT), 1974 DCSO

V053070

U.S. File No. 64/74-38

RENEWAL

Monument Set (Procedure and Description)

NONE

Monument Detail

N/A

New Accessories

10" DIA POPLAR BARK SCRIBED "SW DLC 53 CS BT"
BEARS N81°E, 42.0 FT

Sketch of Monument, Acessories, and General Area

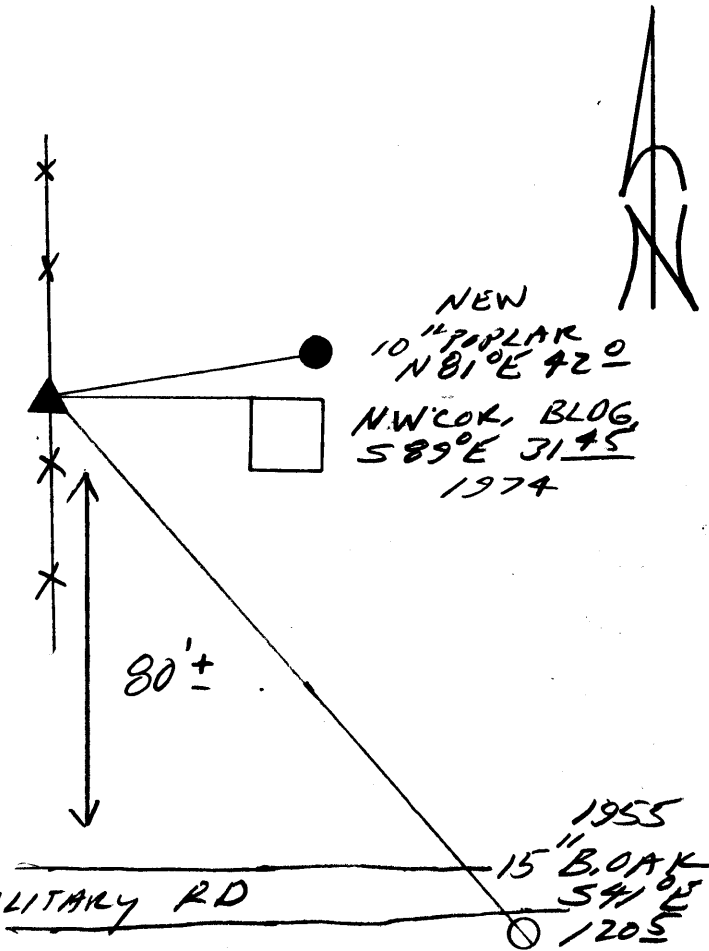

Location & Comments

B&TP LIES 6" EAST OF A N—S RUNNING FENCE LINE

Comp. Declin. 17¾°E
Agency OCSO
Party Chief RANDALL W. SMITH
Notekeeper
Witnesses STEPHEN T. BLAISE

Address

Surveyor's Seal

REGISTERED
PROFESSIONAL
LAND SURVEYOR

EXPIRES 6-30-98

OREGON
JULY 25, 1980
RANDALL W. SMITH
2469