FILED

Date: 9-24-97 By: PSC

This survey consists of:

Map: _____

Narrative: _____

Corner Rec: CS 64/78-4

DOUGLAS COUNTY SURVEYOR

GOVERNMENT CORNER RESTORATION FORM

Township 30 Range 9W Sec. 1 County DOUGLAS

State OR Date 9-18-97 No. _____

Corner Designation

1/4 S2/S1

____ Condition Report Only
____ Not Found
✓ Renewed
____ Unrecorded
____ Surveyed In
____ Referenced Out

Previous Renewals #107 M49-51

Monument(s) Found: (Condition and Source)

2 1/2" DIA BRASS CAP ON A 1 1/2" O.D. IRON PIPE PROTRUDES 6" ABOVE GROUND BC/IP IS PLUMB AND FIRMLY SET.

MONUMENT DETAIL

T30S R9W W.M.

1/4 S2/S1

1974

Accessories Found:

24" NOW 22" DIA 4 FT HIGH CEDAR STUMP WITH VISIBLE SCRIBING "1/4 S2 BT" NOTE: THIS BT HAS SLIPPED OUT OF POSITION, NOW BEARS N 4°W, 64 FT (REC N 13°W, 66.7 FT REN #107

36" NOW 34" DIA 3 FT HIGH ROTTED D. FIR STUMP WITH SCRIBING VISIBLE "1/4 S1 BT" BEARS S 18°E, 94.0 FT (AGREES WITH REC) REN #107

C.S. File No. 64/78-4

✓167

RENEWAL

Monument Set (Procedure and Description)

NONE

Monument Detail

N/A

New Accessories

6" D.FIR DOUBLE BLAZED AND SCRIBED "1/4 S2 CSBT" BEARS S68°W 8.2 FT

15" D.FIR DOUBLE BLAZED AND SCRIBED "1/4 S1 CSBT" BEARS S59°E, 35.0 FT

8" D.FIR DOUBLE BLAZED AND SCRIBED "1/4 S2 CSB" BEARS N9°W, 12.0 FT

8" D.FIR DOUBLE BLAZED AND SCRIBED "1/4 S1 CSBT" BEARS S15½°E, 24.5 FT

Sketch of Monument, Acessories, and General Area

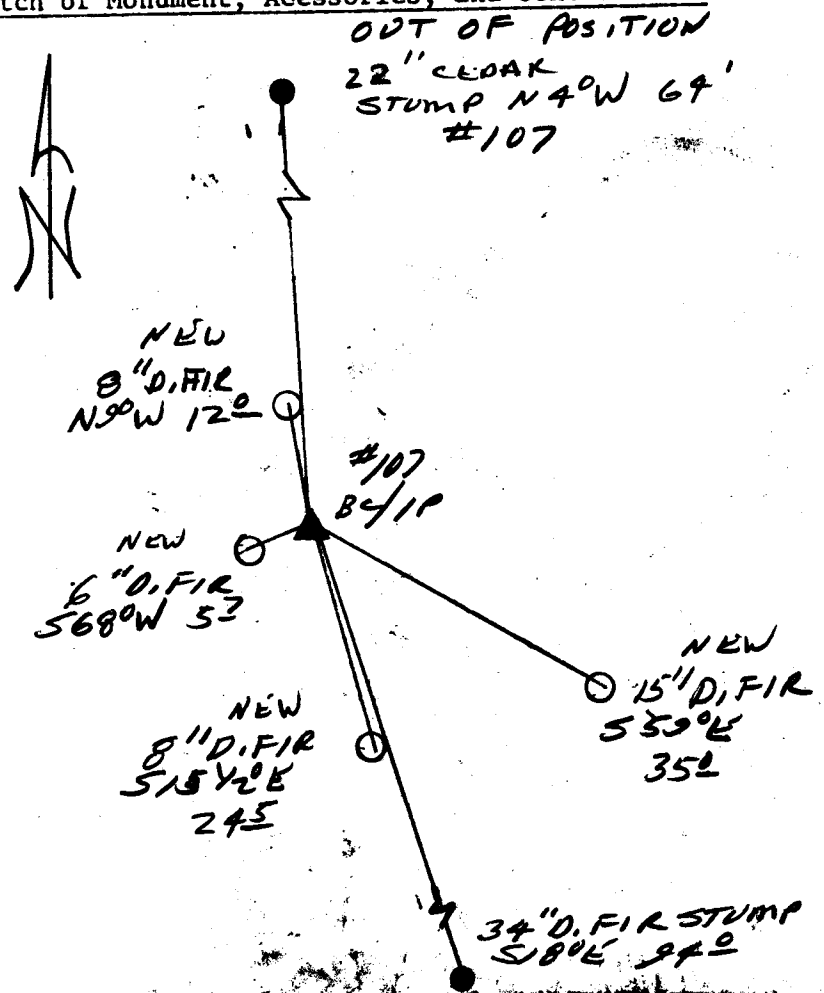

Location & Comments

Comp. Declin. 17¾°E

Agency DCSO

Party Chief RANDALL W. SMITH

Notekeeper [illegible]

Witnesses STEPHEN J. FLAUSO

Address

Surveyor's Seal

REGISTERED PROFESSIONAL LAND SURVEYOR

EXPIRES 6-30-99

OREGON JULY 25, 1990 RANDALL W. SMITH 2469