M 125-25

FILED

Date: 7-9-96 By: MP
This survey consists of:
Map: M 125-25
Narrative: —
Corner Rpt: C.S. 65/8-1A

DOUGLAS COUNTY SURVEYOR

OREGON CORNER RESTORATION FORM

Section 17 Township 22S Range 8W

County Douglas Date July 3, 1996

Corner Designation

SW Corner DLC No. 47
(Witness Corner)

___ Condition Report Only
___ Not Found
X Renewed
___ Unrecorded
___ Surveyed In
___ Referenced Out

Previous Renewals/Surveys, etc.
Douglas County Surveyor, 1962
U.S.B.L.M. 1963, Brooks & Jelley

Monument(s) & Accessories Found: (Condition and Source)
Found D. County Surrey Office Brass Cap w/Iron Pipe, from which a:
24" D. Fir BT stump w/face O/G, bears S74°E, 61.5 Feet.
30" D. Fir BT, Face overgrown, bears S78°W, 6.2 Feet.

Monument Detail

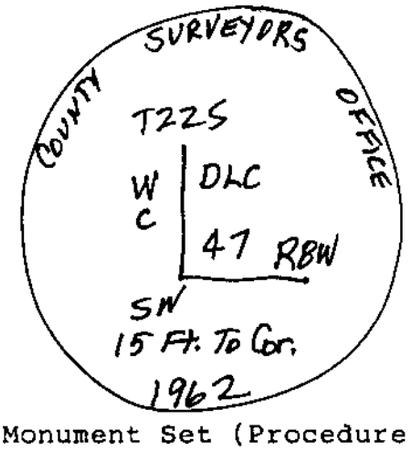

Sketch

2½" Brass Cap on 1½" Iron Pipe

Note: This Witness Corner is 15.2 Feet East of True Position of SW Corner D.L.C. No. 47

Monument Set (Procedures and Description)
None.

New Accessories
Set a 6 Foot Steel Fence Post due East, 1.2 Feet of Corner.
5" D. Fir BT, Inscribed "W.C. DLC BT" bears N20°E, 22.6 Feet.
6" D. Fir BT, Inscribed " " " " " bears S69°E, 49.2 Feet.

Location & Comments
True D.L.C. Corner falls in Creek which Flows S35°E.

Compass Declination 20°E
Firm/Agency Shaner Engineering, Inc.
Address P.O. Box 1430
Roseburg, Oregon 97470
Party Chief B. Shaner
Notes " "
Witness David Snyder

Surveyor's Seal

REGISTERED PROFESSIONAL LAND SURVEYOR
Bruce A Shaner
OREGON OCT. 4, 1957 BRUCE A. SHANER 430

Renews June 30, 1998.

C.S. File No. 65/8-1A

M 125 - 25

FILED

Date: 7-9-96 By: JP

This survey consists of:

Map: M 125 - 25

Narrative: —

Corner Rpt: C.S. 65/8-1B

DOUGLAS COUNTY SURVEYOR

OREGON CORNER RESTORATION FORM

Section 17 Township 22S Range 8W

County Douglas Date July 3, 1996

Corner Designation

SW Corner DLC No. 46

X Condition Report Only
___ Not Found
___ Renewed
___ Unrecorded
___ Surveyed In
___ Referenced Out

Previous Renewals/Surveys, etc.

U.S.B.L.M. 1963, Brooks & Jelley

Monument(s) & Accessories Found: (Condition and Source)

Found U.S.B.L.M. Brass Cap w/Iron Pipe, from which a:
30" D. Fir BT Stump w/scribes visible bears S19°W, 6 6/10 Feet.
16" Oak BT, Face O/Grown, bears N7°E, 75 2/10 Feet.
30" W. Fir BT, " " ", bears S57°E, 27 1/10 Feet.
26" D. Fir BT, " " ", bears N50°W, 5 1/10 Feet.

Monument Detail

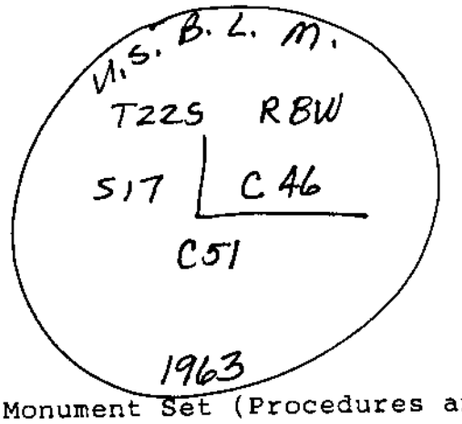

Sketch

3" Brass Cap on 2½" Iron Pipe

Monument Set (Procedures and Description)

N/A

New Accessories

N/A

Location & Comments

None.

Compass Declination 20°E

Firm/Agency Shaner Engineering, Inc.

Address P.O. Box 1430
Roseburg, Oregon 97470

Party Chief B. Shaner

Notes " "

Witness David Snyder

Surveyor's Seal

REGISTERED PROFESSIONAL LAND SURVEYOR

Bruce A Shaner

OREGON OCT. 4, 1957 BRUCE A. SHANER 430

Renews June 30, 1998.

C.S. File No. 65/8-1B

M 125 - 25

FILED

Date: 7-9-96 By: AP
This survey consists of:
Map: M 125 - 25
Narrative: —
Corner Rpt: C.S. 65/8-1C

DOUGLAS COUNTY SURVEYOR

OREGON CORNER RESTORATION FORM

Section 17 Township 22S Range 8W

County Douglas Date July 3, 1996

Corner Designation

Property Corner on West Line O.L.C. No. 46 at 199.54 Feet North of SW Corner O.L.C. No. 46.

___ Condition Report Only
___ Not Found
___ Renewed
___ Unrecorded
X Surveyed In
___ Referenced Out

Previous Renewals/Surveys, etc.

None.

Monument(s) & Accessories Found: (Condition and Source)

None.

Monument Detail

Sketch

1½" Aluminum Cap on a 5/8" x 30" Iron Rod

Monument Set (Procedures and Description)

Set Mon. as above as part of Property Line Survey.

New Accessories

48" D. Fir BT, I bark scribed "PCBT" bears S73°W, 26.2 Feet to Face of scribe.
16" Maple BT, I bark scribed "PCBT" bears N32°E, 23.2 Feet to Face of Scribe.

Location & Comments

None.

Compass Declination 20°E
Firm/Agency Shaner Engineering, Inc.
Address P.O. Box 1430
Roseburg, Oregon 97470
Party Chief B. Shaner
Notes " "
Witness David Snyder

Surveyor's Seal

REGISTERED PROFESSIONAL LAND SURVEYOR

Bruce A Shaner

OREGON
OCT. 4, 1957
BRUCE A. SHANER
430

Renews June 30, 1998.

C.S. File No. 65/8-1C

M 125-25

FILED

Date: 7-9-96 By: JP
This survey consists of:
Map: M 125-25
Narrative: —
Corner Rpt: C.S. 65/8-10

DOUGLAS COUNTY SURVEYOR

OREGON CORNER RESTORATION FORM

Section 17 Township 22S Range 8W

County Douglas Date July 3, 1996

Corner Designation

NW Corner DLC No. 46

X Condition Report Only
___ Not Found
___ Renewed
___ Unrecorded
___ Surveyed In
___ Referenced Out

Previous Renewals/Surveys, etc.

U.S.B.L.M. 1963, Brooks & Jelley

Monument(s) & Accessories Found: (Condition and Source)

Found U.S.B.L.M. Brass Cap w/Iron Pipe, from which a:
28" W. Fir BT, face O/grown, bears S15°E, 44.9 Feet.
22" W. Fir BT, " " " , bears N41°W, 38.9 Feet.
1½" Iron Pipe sets along side B.C.
D. Fir (Stump) BT, 65" Diam., badly rotted, bears N67°E, 55.4 ft.

Monument Detail

U.S. B.L.M.
T22S, R8W
S17 | C46
1963

Sketch

3" Brass Cap on 2½" Iron Pipe

Monument Set (Procedures and Description)

N/A

New Accessories

Set 6 Foot Steel Fence Post at B.C.
No Trees Available in SW or NE Quadrant.

Location & Comments

None.

Compass Declination 20°E
Firm/Agency Shaner Engineering, Inc.
Address P.O. Box 1430
Roseburg, Oregon 97470
Party Chief E. Shaner
Notes
Witness David Snyder

Surveyor's Seal

REGISTERED PROFESSIONAL LAND SURVEYOR
Bruce A Shaner
OREGON OCT. 4, 1957 BRUCE A. SHANER 430

Renews June 30, 1998.

C.S. File No. 65/8-10