

REWITNESSED CORNER FOR
STATE OF OREGON - DEPARTMENT OF FORESTRY

Closing corner for sections 2 and 3, T.23S., R.10W., W.M., Douglas county, Oregon.

ORIGINAL: LEVI WALKER, 1906.

Post (missing) from which a:

20" Hemlock bears S58°E 64 lks.; missing.
24" alder bears S86°W 23 lks.; missing.

REESTABLISHED: ARNOLD G. GIBSON, 1958.

Oregon State Board of Forestry pipe and cap (in place) from which a:

24" Hemlock stump bears S47°W 92.5 ft.; now 13" x 3' high rotten stump in place, face rotted away.
18" Hemlock bears N38 1/2°W 58.5 ft.; now 25" x 2' high rotten stump in place, face missing.
4" x 4" x 72" White painted cedar post bears Southeast 1.0 ft.; now rotted and fallen over.

REWITNESSED: BUREAU OF LAND MANAGEMENT, 1970.

5" Cherry bears S10 3/4°E 14 1/2 lks.; now down and rotten, bearing tree tag on top of log.
7" Alder S33°W 45 lks.; now 16" in place, bark scribes visible.


REWITNESSED

MAGNETIC VARIATION 20 1/2° EAST

Orange carsonite marker CBM-250 labled witness post bears S43°W 2.0 ft. to base.
Orange carsonite marker CBM-250 labled witness post bears S35°E 2.45 ft. to base.

Dated September 25, 1996

Rewitnessed by:

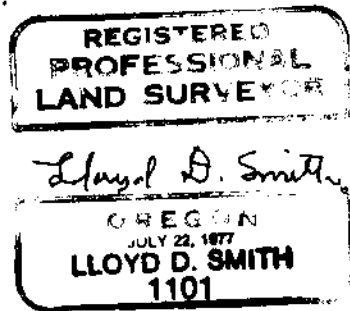

Exp. 6/30/98

Present and witnessed by Tim Van Vleet

Oregon Dept. Of Forestry
300 5th Street. Bay Park
Coos Bay, Oregon 97420

FILED

Date: 10-31-96 By: JC
This survey consists of:
Map: _____
Narrative: _____
Corner Rpt: 65/8-11

DOUGLAS COUNTY
SURVEYOR

C.S. File No. 65/8-11