FILED

Date: 11-7-96 By: JP

This survey consists of:

Map:

Narrative:

Corner Rpt: C.S 65/9-14

DOUGLAS COUNTY SURVEYOR

GOVERNMENT CORNER RESTORATION FORM

Township 31S Range 7W Sec. 27 County DOUGLAS

State OR Date 9-12-1996 No.

Corner Designation

1/4 S28 | S27

___ Condition Report Only
___ Not Found
✓ Renewed
___ Unrecorded
___ Surveyed In
___ Referenced Out

Previous Renewals 1964 BLM P.I. # 400240

Monument(s) Found: (Condition and Source)

3 1/4" DIA. BRASS CAP ON A 2 1/2" O.D. IRON PIPE, PROTRUDES 6" ABOVE GROUND. (1964)

MONUMENT DETAIL

U.S. CADASTRAL SURVEY
T31S R7W
1/4
S28 | S27

1964
BUREAU OF LAND MANAGEMENT

Accessories Found:

20" NOW 24" DIA. 5 FT HIGH D. FIR STUMP WITH A FULLY HEALED SINGLE BLAZE, BEARS N67°E, 12.5 FT (AGREES WITH REC.) 1964

13" NOW 18" DIA. 7 FT HIGH D. FIR STUMP WITH A FULLY HEALED DOUBLE BLAZE, BEARS S51°W, 45.2 FT (REC. S51°W 46.8 FT) 1964

400240
C

C.S. File No. 65/9-14

RENEWAL

Monument Set (Procedure and Description)

Monument Detail

New Accessories

7" DIA PINE DOUBLE BLAZED AND SCRIBED "1/4S27CSBT" BEARS N55°E 55± FT

3" DIA. D.FIR DOUBLE BLAZED AND SCRIBED "XBT" BEARS S41°W, 14.5 FT

5" DIA. D.FIR DOUBLE BLAZED AND SCRIBED "1/4S27CSBT" BEARS S25°E 16.3FT

5" DIA. PINE DOUBLE BLAZED AND SCRIBED "1/4S27CSBT" BEARS N3°E, 52.1 FT

Sketch of Monument, Acessories, and General Area

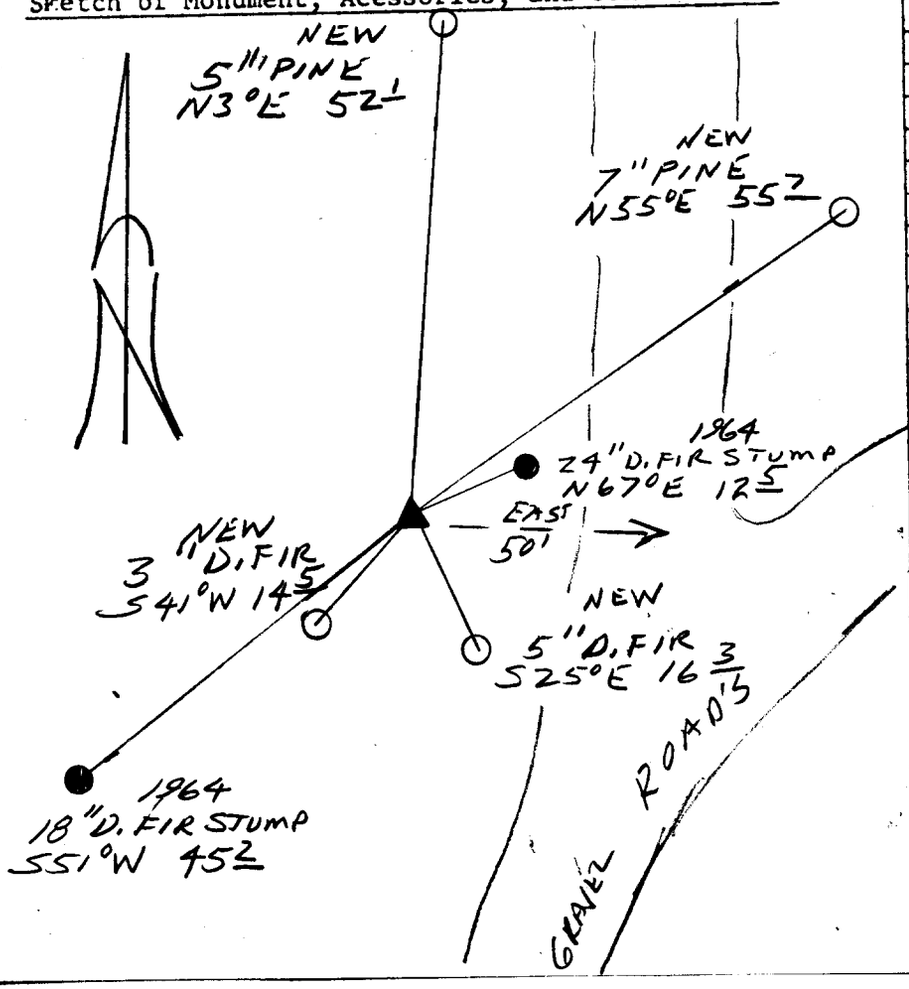

Location & Comments

Comp. Declin. 17 3/4°E

Agency DCSO

Party Chief RANDALL W SMITH

Notekeeper Randall W Smith

Witnesses STEPHEN J FLAUSE

Address

Surveyor's Seal

REGISTERED
PROFESSIONAL
LAND SURVEYOR

Randall W Smith
EXPIRES 6-30-98

OREGON
JULY 25, 1990
RANDALL W. SMITH
2469