R

FILED

GOVERNMENT CORNER RESTORATION FORM

Date: 11-12-96 By: JD

This survey consists of:
Map:
Narrative:
Corner Rpt: CS 65/9-15

Township 3 S Range 7 W Sec. 33 County DOUGLAS

State OR Date 9-16-96 No.

DOUGLAS COUNTY SURVEYOR

Corner Designation

1/4 S33 | S34

___ Condition Report Only
___ Not Found
✓ Renewed
___ Unrecorded
___ Surveyed In
___ Referenced Out

Previous Renewals 1964 BLM PI# 400140

MONUMENT DETAIL

Monument(s) Found: (Condition and Source)

3 1/4" DIA BRASS CAP ON AN IRON PIPE IS FOUND 6" BELOW GROUND (1964 BLM)

DEPT. OF THE INTERIOR
T 3 S R 7 W
1/4
S33 | S34
1964
BUREAU OF LAND MANAGEMENT

Accessories Found:

32" NOW 45" DIA. DOWN D. FIR LARGE ROOT HOLE AT RECORD "N 70° W 12.5 FT". OBT ORIG. NE BT NOW GONE.

8" NOW 11" DIA. 1 FT ROTTED D. FIR STUMP, SCRIBING FOUND "BT" BEARS S 81 1/2° E, 23.8 FT (AGREES WITH REC.) 1964

8" NOW 14" DIA. D. FIR WITH A FULLY HEALED SINGLE BLAZE, BEARS S 13 1/2° W, 27.4 FT (AGREES WITH REC.) 1964

U.S. File No. 65/9-15

400140

RENEWAL

Monument Set (Procedure and Description)

N/A

Monument Detail

N/A

New Accessories

6" DIA. D.FIR DOUBLE BLAZED AND SCRIBED "1/4 S34 CS BT"
BEARS S 89°E, 46.8 FT
6" DIA. D.FIR DOUBLE BLAZED AND SCRIBED "1/4 S33 CS BT"
BEARS S 52°W, 26.1 FT
19" DIA. MADRONE DOUBLE BLAZED AND SCRIBED "1/4 S33 CS BT"
BEARS N 29½°W, 30.7 FT

Sketch of Monument, Acessories, and General Area

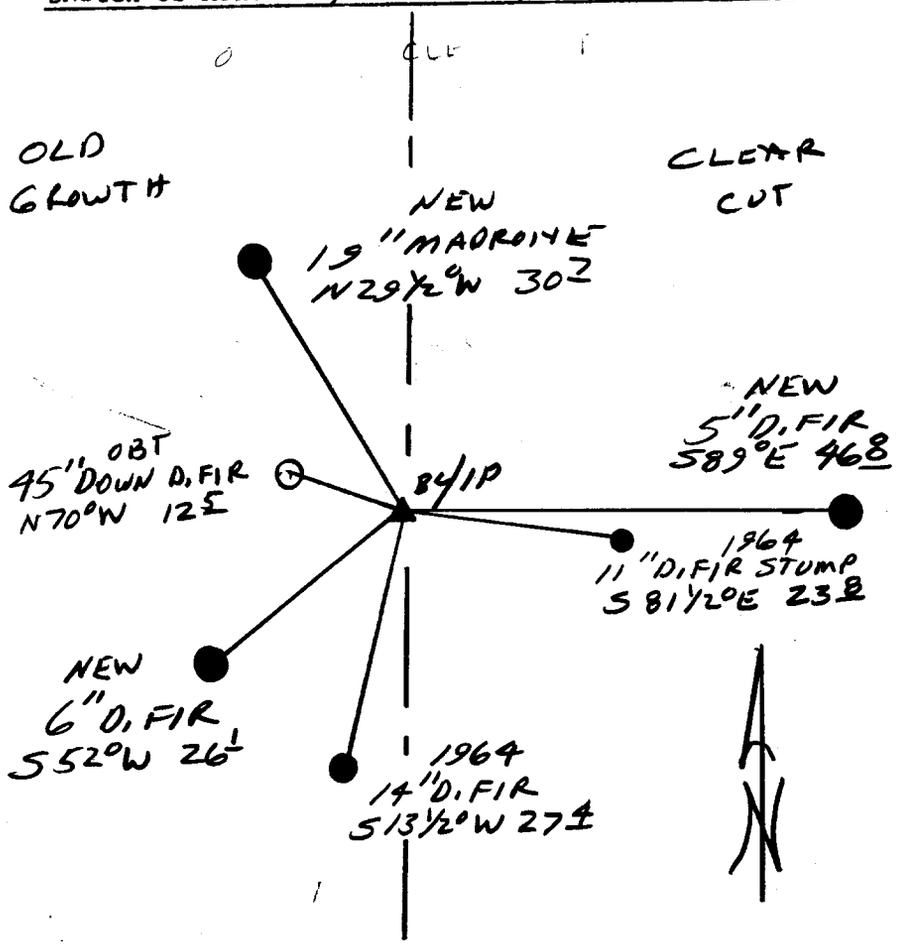

Location & Comments

Comp. Declin. 17 3/4°E
Agency DCSO
Party Chief RANDALL W. SMITH
Notekeeper Randall W. Smith
Witnesses STEPHEN J. FLAUSE

Address

Surveyor's Seal

REGISTERED PROFESSIONAL LAND SURVEYOR
Randall W. Smith
EXPIRES 6-30-90
OREGON
JULY 25, 1990
RANDALL W. SMITH
2469