FILED

Date: 11-12-96 By: JP

This survey consists of:
Map:
Narrative:
Corner Rpt: C.S. 65/9-16

GOVERNMENT CORNER RESTORATION FORM

Township 25S Range 7W Sec. 27 County DOUGLAS

State OR Date 9-17-96 No.

Corner Designation

1/4 S27 / S34

DOUGLAS COUNTY SURVEYOR

___ Condition Report Only
___ Not Found
✓ Renewed
___ Unrecorded
___ Surveyed In
___ Referenced Out

Previous Renewals 1968 BLM

MONUMENT DETAIL

Monument(s) Found: (Condition and Source)

3¼" DIA. BRASS CAP ON A 2½" O.D. IRON PIPE, PROTRUDES 2" ABOVE GROUND (1968)

U.S. DEPT. OF THE INTERIOR
T25S R7W

1/4 S27 / S34

1968

BUR. OF LAND MANAGEMENT

Accessories Found:

18" NOW 41" DIA DOWN B. OAK (FALLEN ON FACE) ROOT HOLE BEARS N89°W, 457.4 FT (AGREES WITH REC.) OBT.

7" NOW 21" DIA. CEDAR WITH A FULLY HEALED SINGLE BLAZE, BEARS N7¼°E, 52.8 FT (AGREES WITH REC) 1968

8" NOW 25" DIA. CEDAR WITH A FULLY HEALED SINGLE BLAZE, BEARS S16°W, 66.0 FT (AGREES WITH REC.) 1968

C.S. File No. 65/9-16

440200

RENEWAL

Monument Set (Procedure and Description)

NONE

Monument Detail

N/A

New Accessories

27"DIA. D.FIR DOUBLE BLAZED AND SCRIBED "1/4 S27 CS BT"
BEARS N 87°W 328.4 FT

26"DIA. CEDAR DOUBLE BLAZED AND SCRIBED "1/4 S34 CS BT"
BEARS S 72°E, 19.8 FT

Sketch of Monument, Acessories, and General Area

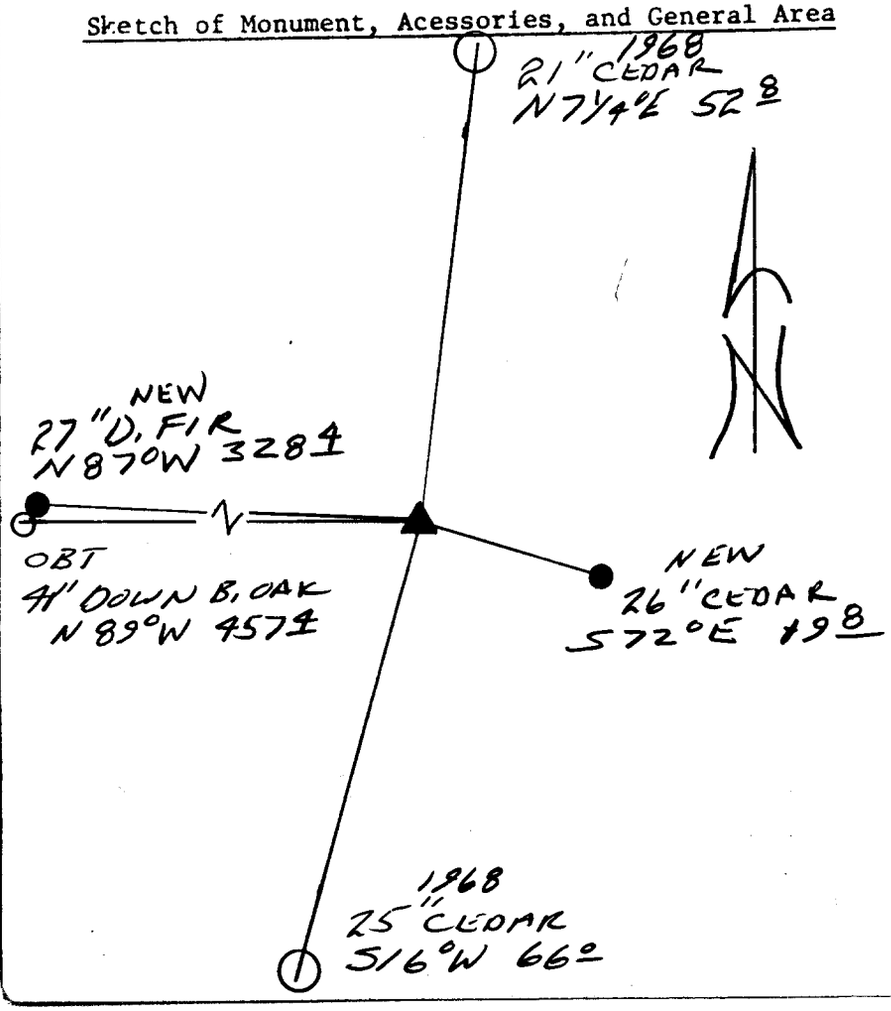

Location & Comments

Comp. Declin. 17 3/4° E
Agency DCSO
Party Chief RANDALL W SMITH
Notekeeper CHARLES W SMITH
Witnesses STEPHEN J FLAUSE

Address

Surveyor's Seal

REGISTERED
PROFESSIONAL
LAND SURVEYOR

Randall W Smith
EXPIRES 6-30-98

OREGON
JULY 25, 1980
RANDALL W. SMITH
2469