T30S R7W NE¼ NW¼ Sec. 35

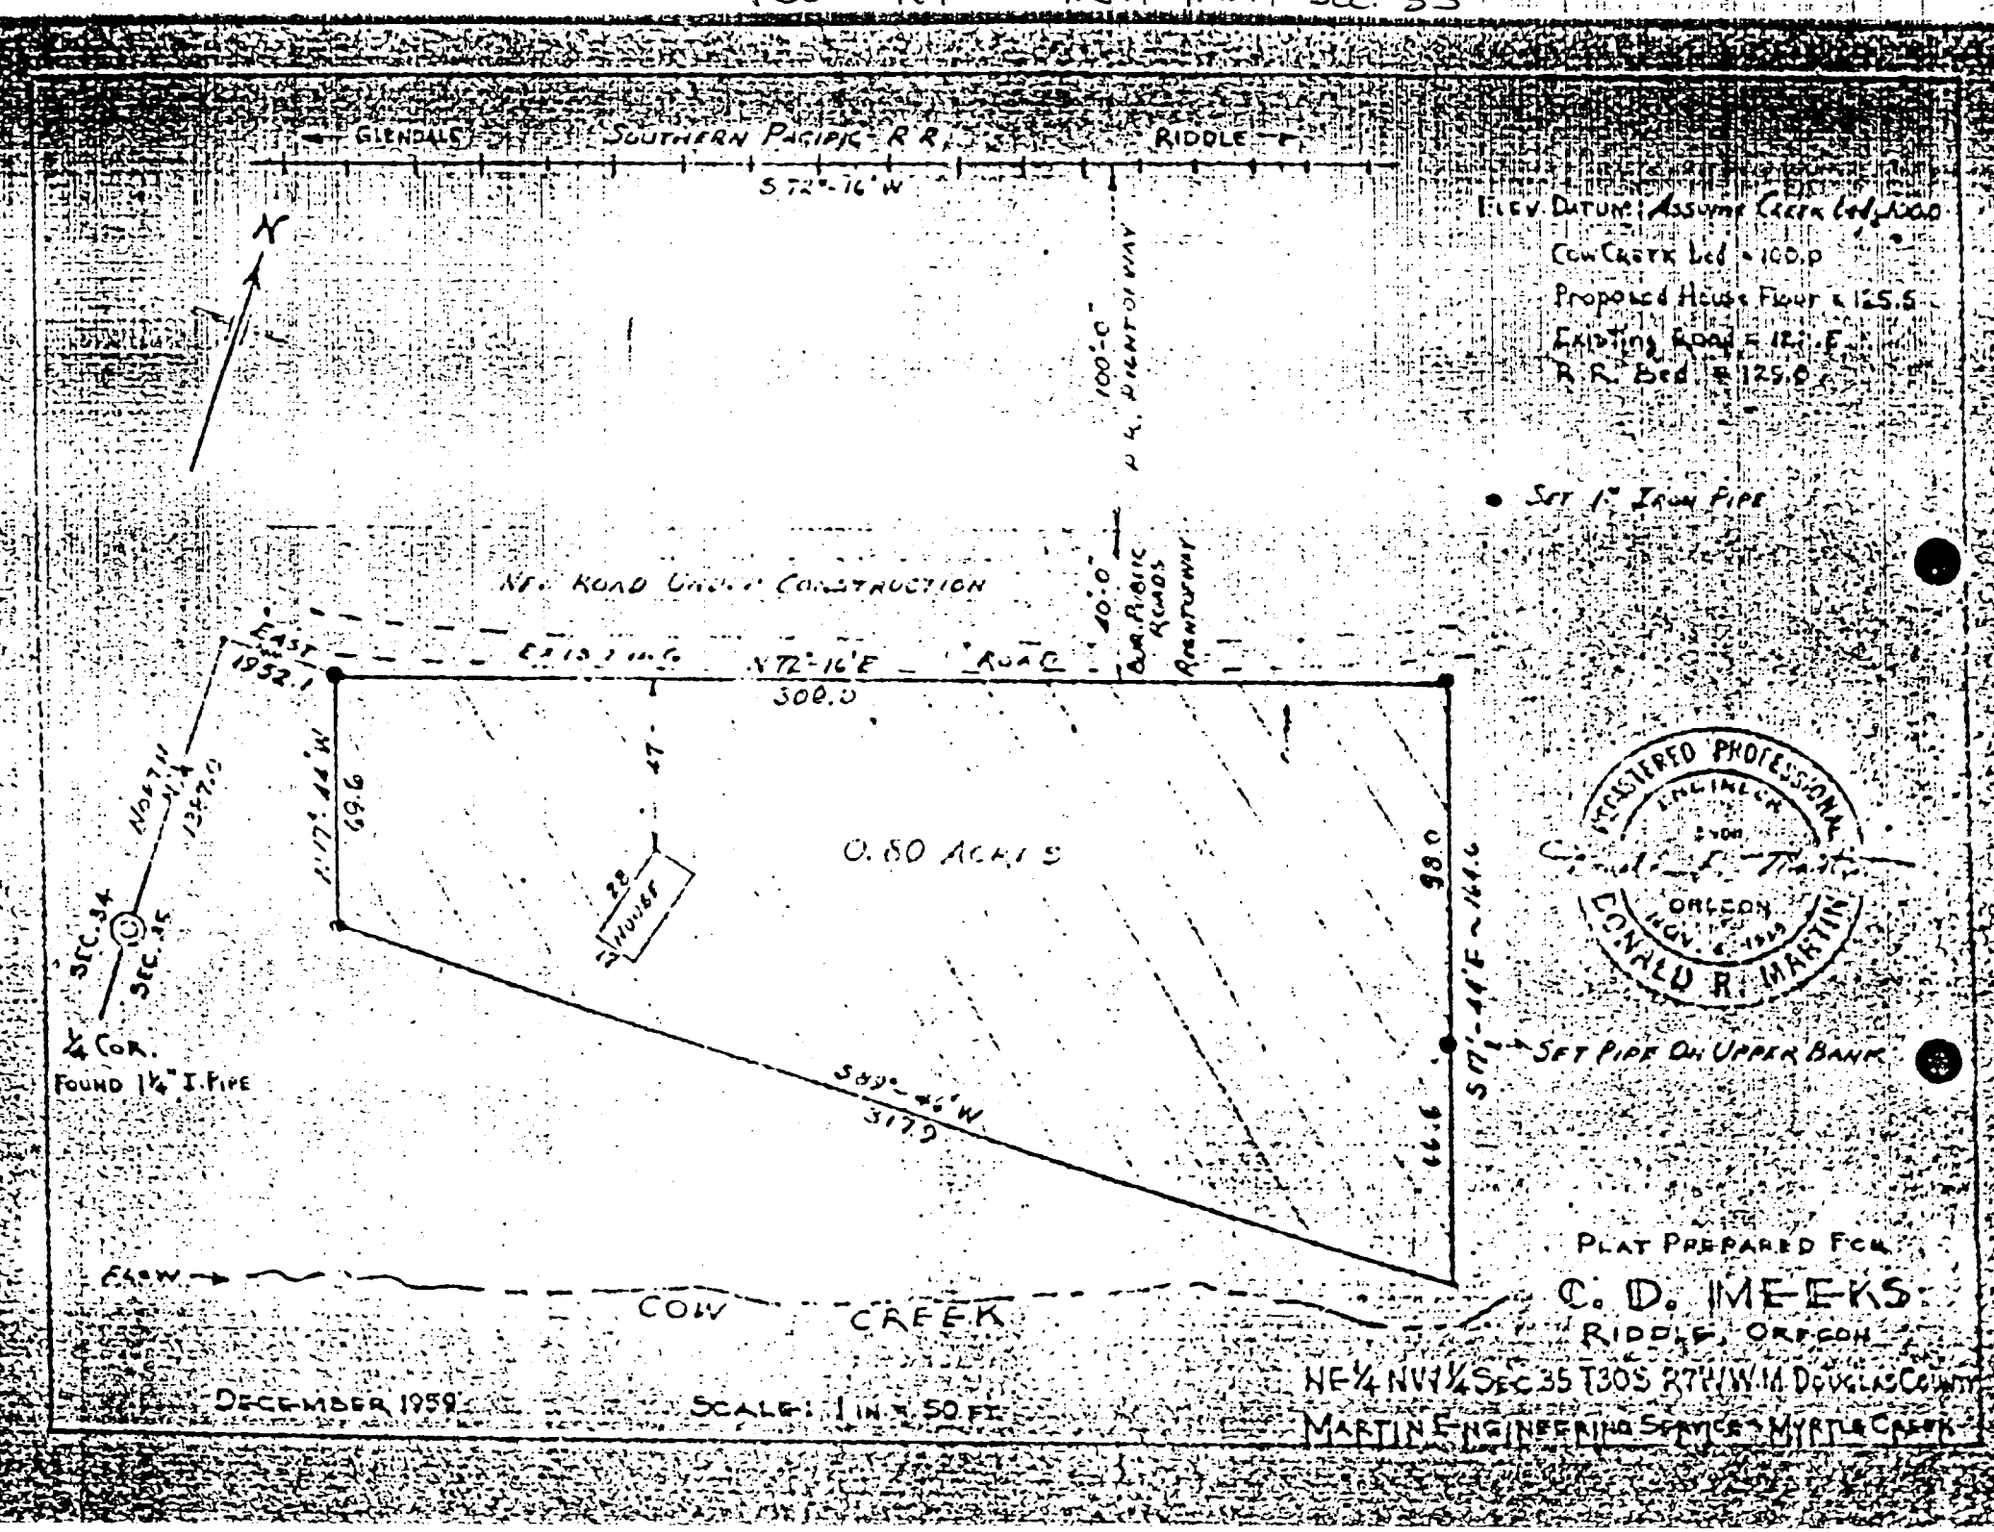

DECEMBER 1959 SCALE: 1 IN. = 50 FT.

PLAT PREPARED FOR
C. D. IMEEKS
RIDDLE, OREGON

NE¼ NW¼ SEC 35 T30S R7W W.M. DOUGLAS COUNTY
MARTIN ENGINEERING SERVICE - MYRTLE CREEK

FILED

Date: 2-11-97 By: JC

This survey consists of:

Map: CS 65/12-1

Narrative: _____

Corner Rpt: _____

DOUGLAS COUNTY SURVEYOR

Received from Kris DeGroot 2/11/97 - Kris obtained this from Douglas County Title Company

COUNTY SURVEYORS FILE DATA
DO NOT REMOVE FROM OFFICE

C.S. File No. 65/12-1