FILED
Date: 8-6-97 By: RC
This survey consists of:
Map: ____
Narrative: ____
Corner Rpt: CS 65/15-9

DOUGLAS COUNTY SURVEYOR

OREGON CORNER RESTORATION FORM

Section 18 Township 21S Range 8W

County Douglas Date 3-18-97

___ Condition Report Only
___ Not Found
X Renewed
___ Unrecorded
___ Surveyed In
___ Referenced Out

Corner Designation
W 1/4 Sec 18 ONLY

1/4
18

Previous Renewals/Surveys, etc. ____

Monument(s) & Accessories Found: (Condition and Source)
1945 GLO IPBC
BTs: 15" FIR S80E 17 LKS GOOD-HEALED FACE
14" FIR N31½E 47 LKS GOOD-HEALED FACE. TAG 7½' UP TREE
ROOT HOLE N85½E, 217 LKS - REMAINS OF 1945 BT

Monument Detail

Sketch

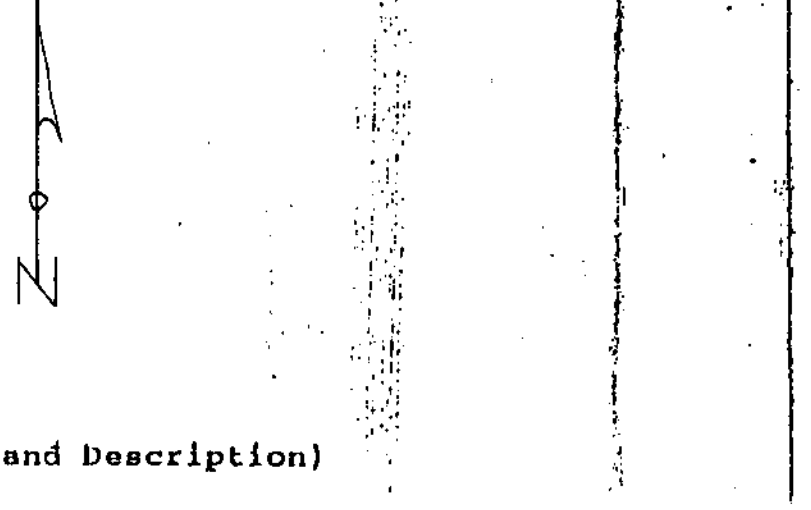

Monument Set (Procedures and Description)

New Accessories
BTs: 11" FIR N4W 17° SCRIBED "¼ BT"
6" FIR S12E 13° SCRIBED "¼ BT"

Location & Comments

Compass Declination 19
Firm/Agency ROSEBURG FOREST PRODUCTS
Address PO BOX 1088
ROSEBURG OR. 97470
Party Chief F. RADDATZ
Notes B. OLSON
Witness ____

Surveyor's Seal

REGISTERED PROFESSIONAL LAND SURVEYOR
Mark F. Smalley
OREGON
JULY 26, 1988
MARK F. SMALLEY
2354

RENEWS 6/30/98

C.S. File No. 65/15-9

✓#74