MAP OF SURVEY

LOCATED in Lots 1 & 2, Block 39, RAILROAD ADDITION to Oakland, SE 1/4 of Section 4, T. 25 S., R.5W., W.M. in Douglas Co., Oregon.

September 19, 2000

FILED
Date: 11/1/2000 By: JP
This survey consists of:
Map: CS 65/29-8
Narrative:
Corner Rpt:
DOUGLAS COUNTY SURVEYOR

SURVEYED FOR: *P.J. BUTLER*
433 N.E. LOCUST
OAKLAND, OREGON

SURVEYED BY: *DAVID EDWARDS LAND SURVEYING*
P.O. BOX 361
OAKLAND, OREGON 97462
PHONE: (541) 459-0512

REGISTERED PROFESSIONAL LAND SURVEYOR
David A. Edwards
OREGON
JULY 26, 1988
DAVID A. EDWARDS
2339
EXPIRES 12/31/01

LEGEND

- ● INDICATES 5/8" DIAM. IRON ROD FOUND PER RM 2-59.
- o INDICATES 5/8" X 30" STEEL PIN W/RED PLASTIC CAP MKD. "D.A. EDWARDS-LS 2339" SET.
- ( ) DENOTES PLAT RECORD DATA UNLESS NOTED OTHERWISE.

BASIS OF BEARINGS: RM 2-59 AS SHOWN. SCALE: 1" = 100'

NARRATIVE

THE PURPOSE OF THIS SURVEY IS TO MONUMENT CORNERS IN LOTS 1 AND 2, BLOCK 39, RAILROAD ADDITION, AS SHOWN HEREON. FOUND CENTERLINE MONUMENTS AND RECORD DATA PER RM 2-59 WERE USED TO COMPUTE THE BLOCK AND LOT CORNER POSITIONS AS SHOWN.

FIELD CREW: DAVID EDWARDS AND BRANT MILLER.

EQUIPMENT: NIKON DTM 430 TOTAL STATION.

COMPS. AND DRAFTING: DAVID EDWARDS.

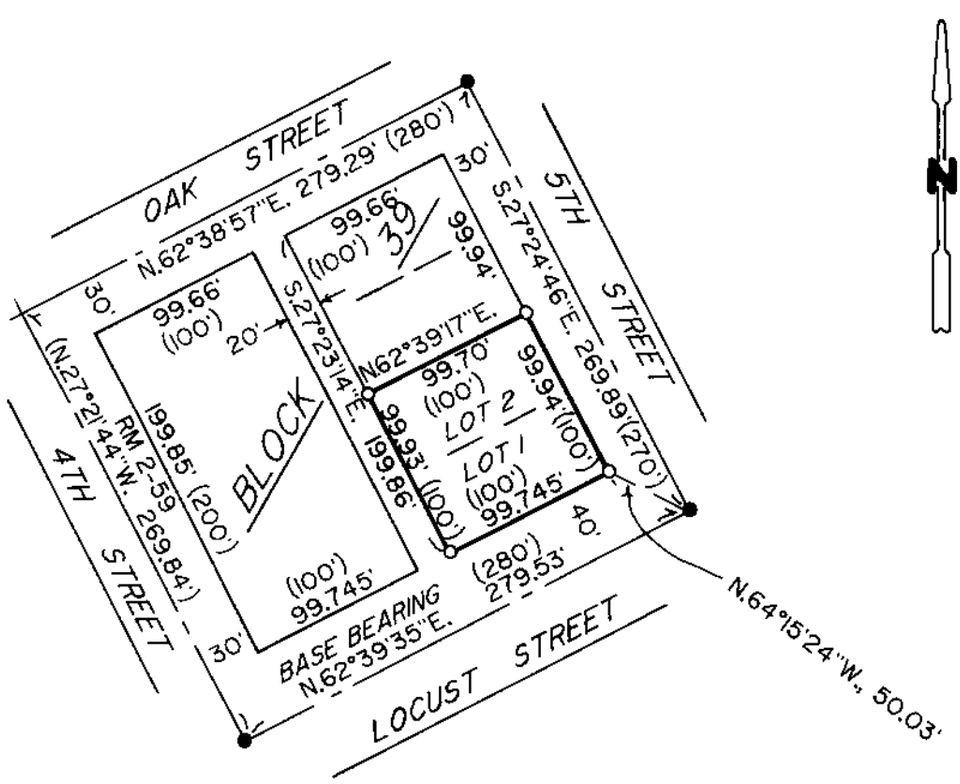

C.S. File No. 65/29-8