OREGON CORNER RESTORATION FORM

CORNER NO. 23

Section 27 Township 32S Range 7W

County Douglas Date March, 2002

Mining Claim
Corner Designation

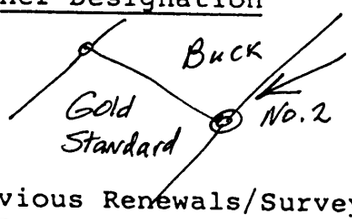

___ Condition Report Only
___ Not Found
X Renewed
___ Unrecorded
___ Surveyed In
___ Referenced Out

Previous Renewals/Surveys, etc.
Briggs, U.S.G.L.O., 1901 Survey Plat
RLS Van Swearingen, Map No. M21-61, 1961 Survey.

Monument(s) & Accessories Found: (Condition and Source)
Found Drill Steel in mound of rock, from which a:
20" Pine BT, original BT, Now blown down & rotten, bears S86½°W, 101 Feet.
12" Madrone BT, scribes visible, bears S41°W, 7.3 feet.
12" Madrone BT, " ", bears N50°E, 6.6 feet.

(No record of Madrone BT's.)

Monument Detail

Sketch

FILED
Date: 3/27/2002 By: X
This survey consists of:
Map: H137-35
Narrative:
Corner Rpt: 65/42-11 thru 39

DOUGLAS COUNTY SURVEYOR

Monument Set (Procedures and Description)

New Accessories
6 Foot Steel Fence Post bears N30°E, 1.0 feet.

Location & Comments

Compass Declination 20°E
Firm/Agency Shaner Engineering
Address P.O. Box 1430 Roseburg, OR 97470
Party Chief B. Shaner
Notes " "
Witness Ron Schneider

Surveyor's Seal

REGISTERED PROFESSIONAL LAND SURVEYOR

Bruce A Shaner

OREGON OCT. 4, 1957 BRUCE A. SHANER 430

Renews June 30, 2002

C.S. File No. 65/42-33