FILED

Date: 3-28-2002 By: SC

This survey consists of:

Map: H 139-61

Narrative:

Corner Rpt: 65/42-40A

DOUGLAS COUNTY SURVEYOR

OREGON CORNER RESTORATION FORM

Section 18 Township 31S Range 4W

County Douglas Date March 27, 2002

Corner Designation

S1/16 C Sec. 18 C

___ Condition Report Only
___ Not Found
___ Renewed
___ Unrecorded
X Surveyed In
___ Referenced Out

Previous Renewals/Surveys, etc.

N/A

Monument(s) & Accessories Found: (Condition and Source)

N/A

Monument Detail

Sketch

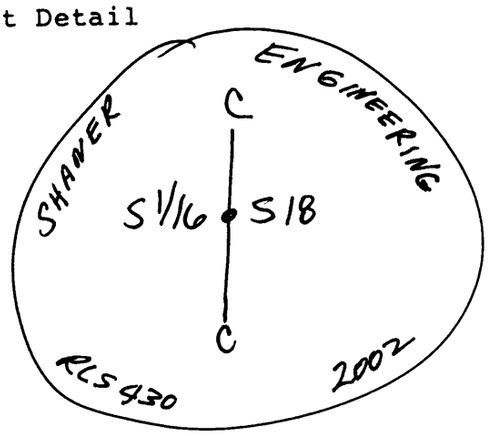

Monument Set (Procedures and Description)

I set a 2½"x30" Alum. Pipe with a 3¼" Alum. Cap, from which a:

New Accessories

12" Cedar BT, Iscribed "CS 1/16 BT", bears N55°W, 21.4 feet.
16" D. Fir BT, " " " " ", bears N22°W, 31.3 feet.
6 Foot Steel Fence Post bears East, 1.0 foot.
" " " " " " North, 1.0 foot.

Location & Comments

Compass Declination 20°E

Firm/Agency Shaner Engineering, Inc.

Address P.O. Box 1430 Roseburg, OR 97470

Party Chief B. Shaner

Notes " "

Witness Ron Schneider

Surveyor's Seal

REGISTERED PROFESSIONAL LAND SURVEYOR

Bruce A Shaner

OREGON OCT. 4, 1957 BRUCE A. SHANER 430

Renews June 30, 2002

C.S. File No 65/42-40A