

FILED

Date: 4-22-2002 By: JL

This survey consists of:

Map: _____

Narrative: _____

Corner Rpt: 65/44-3

CORNER NOTES

MARCH 2002

BY: TONY HOSTETTER
63538 PINTAIL DR.
COOS BAY, OR 97420

FOR: WEYERHAEUSER COMPANY
98674 DELLWOOD LANE
COOS BAY, OR 97420

DOUGLAS COUNTY
SURVEYOR

SW 1/16 CORNER, SECTION 36, T. 26 S., R. 8 W., W.M.


DOUGLAS COUNTY, OREGON

FOUND: 1973 BRASS CAP AND BTS AS DESCRIBED BY SHANER (M49-49).
BT @ S 75°E IS NOW A SNAG.

NEW BTS:

14" FIR, SCRIBED "S36 1/16 BT", WEYCO TAG,
BEARS: S 33°24'E, 9.6 FEET TO SPIKE PLACED IN ROOT COLLAR BELOW
SCRIBING.

16" FIR, SCRIBED "S36 1/16 BT", WEYCO TAG,
BEARS: N 33° 15'W, 14.5 FEET TO SPIKE PLACED IN ROOT COLLAR BELOW
SCRIBING.

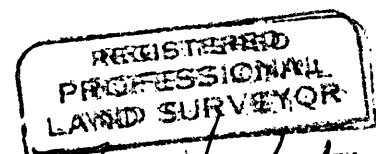

Tony Hostetter
OREGON
JAN 15 1980
TONY HOSTETTER
1975

C.S. File No 65/44-3