FILED
Date: 7/23/2002 By: JP
This survey consists of:
Map: M 140-41
Narrative:
Corner Rpt: CS 65/44-7 B
DOUGLAS COUNTY SURVEYOR

OREGON CORNER RESTORATION FORM

Section 26 Township 32S Range 4W

County Douglas Date July 22, 2002

Corner Designation

1/4
S27 | S26

___ Condition Report Only
___ Not Found
X Renewed
___ Unrecorded
___ Surveyed In
___ Referenced Out

Previous Renewals/Surveys, etc.
U.S.G.L.O., 1896, Surveyor Nicklin
U.S.B.L.M., 1959, " Thielsen

Monument(s) & Accessories Found: (Condition and Source)
Found 2 1/2" Iron Pipe w/3 1/4" Brass Cap, from which a:
Original Corner, 14"x10"x8" Basalt Stone, sets South, 1.0 foot.
36" D. Fir BT, face overgrown, bears S2°W, 112.0 feet (record 118 1/10 ft.)
40" D. Fir BT stump, was snag, bears N67°W, 20.1 ft. To Face.
(Face overgrown)

Monument Detail

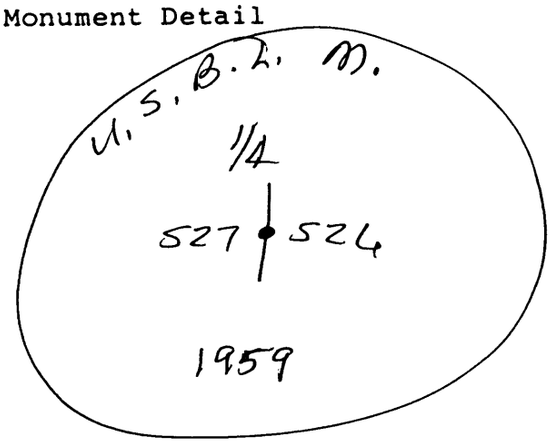

Sketch

Monument Set (Procedures and Description)
None.

New Accessories
10" D. Fir BT, Iscribed "1/4 S27 BT" bears S52°W, 19.2 Feet.
8" " " ", " " "1/4 S26 BT" bears S52°E, 10.4 Feet.

6 Foot Steel Fence Post bears North, 1.0 foot.

Location & Comments

Compass Declination 20°E
Firm/Agency Shaner Engineering, Inc
Address P.O. Box 1430 Roseburg, OR 97470
Party Chief B. Shaner
Notes
Witness Gregg Donshine

Surveyor's Seal
REGISTERED PROFESSIONAL LAND SURVEYOR
Bruce A. Shaner
OREGON OCT. 4, 1957 BRUCE A. SHANER 430
Renews June 30, 2004

C.S. File No 65/44-7 B