FILED

Date: 6/10/2003 By: JP

This survey consists of:

Map: M142-36

Nar[illegible]: _____

Corner Rpt: CS 65/45-32 F

DOUGLAS COUNTY SURVEYOR

CORNER REPORT FORM

Section 4 Township 31 S Range 4 W.W.M.

Douglas County Date May 25, 2003

CORNER DESIGNATION

W 1/16 80

Condition Report only
Not Found
Renewed
Unrecorded
x Surveyed In
Referenced out

Previous Renewals/Surveys, etc:

Monument(s) & Accessories Found: (Condition and Source)

Monument Detail

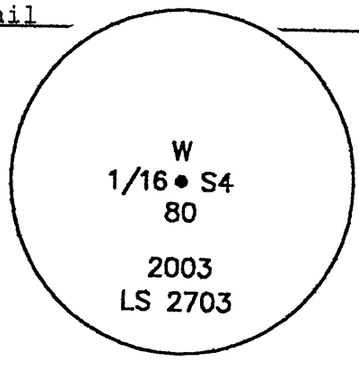


Sketch

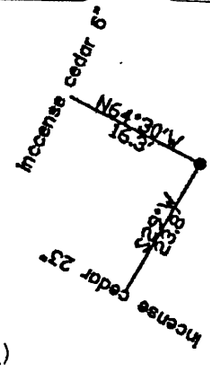


Monument Set (Procedures and Description)

2-1/2" aluminum cap on 5/8" x 30" iron rod 29" deep.

Set at the intersection between 1/16 80 (west line S4) - C 1/16 80 and W 1/16 - CW 1/16.

New Accessories

A incense cedar 6" Bears N64-30W, 16.3 feet face scribed "W1/16 80 S4 BT".
A incense cedar 23" Bears S29W, 23.8 feet face scribed "W1/16 80 S4 BT".

Distances are to spikes set at side center. Bearing trees were paint banded and face painted red. Tags were marked and placed on trees facing corner.

There is a 6" fir adjacent to the NE quadrant of cap which may grow over cap.

Location & Comments

Corner falls on 70% east facing slope approximately 377 feet east of the east shoulder of a rocked haul road.

Compass Declination 19 East

Firm/Agency: i.e. Engineering, Inc.

Address: 741 SE Jackson
Roseburg, OR 97470

Party Chief: Bruce Webster

Notes:

Witness:

Surveyor's Seal

REGISTERED PROFESSIONAL LAND SURVEYOR

OREGON
JUNE 30, 1995
JERRY LEE ESTABROOK
2703

C.S. File No 65/45-32 F Exp. Date 12/31/03