FILED

Date: 9-16-2003 By: X

This survey consists of:

Map: _____

Name: _____

Corner Rpt. 65/48-16

DOUGLAS COUNTY SURVEYOR

OREGON CORNER RESTORATION FORM

Section 26 Township 26 S Range 3W

County DOUGLAS Date 8-28-03

Corner Designation

SE Sec 26 600200

X Condition Report Only
___ Not Found
___ Renewed
___ Unrecorded
___ Surveyed In
___ Referenced Out

Previous Renewals/Surveys, etc. _____

Monument(s) & Accessories Found: (Condition and Source)

1966 DCSO 1PBC

34" FIR S38W 12.8 (RECORD S35W 13.2) HEALED

14" MAPLE S71E 46.3 (RECORD S70½E 46.3) HEALED

10" YEW N60E 27.1 (RECORD N57E 27.7) SCRIBE U/S

42" ROTTEN FIR STUMP N24W 21.4 (RECORD N30W 21.1)

28" CEDAR N86W 30.4 HEALED

Monument Detail

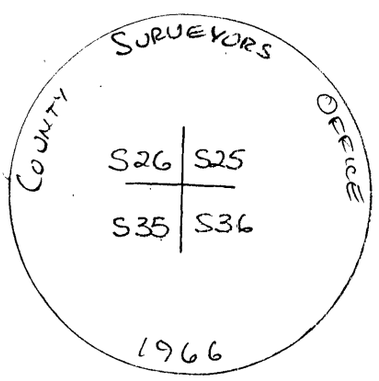


Sketch

Monument Set (Procedures and Description)

New Accessories

Location & Comments

Compass Declination 19½

Firm/Agency ROSEBURG FOREST PRODUCTS

Address P.O. Box 1088

ROSEBURG OREGON 97470

Party Chief Bill Olson

Notes MIKE FROMDAHL

Witness _____

Surveyor's Seal

REGISTERED PROFESSIONAL LAND SURVEYOR

Mark F. Smalley

OREGON JULY 26, 1988 MARK F. SMALLEY 2354

RENEWS 6/30/04

C.S. File No 65/48-16