FILED

Date: 9-16-2004 By: nw

This survey consists of:

Map: _____

Narrative: _____

Corner Rpt: CS 65/52-11

DOUGLAS COUNTY SURVEYOR

OREGON CORNER RESTORATION FORM

Section: 14 **Township:** 29S **Range:** 9W

County: Douglas **Date:** 9-15-04

Corner Designation

1/4 **S15** | **S14**

- [ ] Condition Report Only
- [ ] Not Found
- [x] Renewed
- [ ] Unrecorded
- [ ] Surveyed In
- [ ] Referenced Out

Previous Renewals / Surveys, etc.:

See 1974 Douglas County renewal.

Monument (s) & Accessories Found: **(Condition & Source)**

Found D.C.S.O. Brass cap
26 1/2" Fir bears N63 1/2*W 44.2'

Monument Detail:

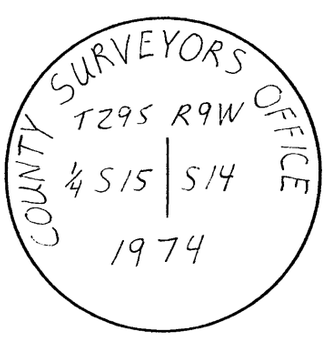

Sketch:

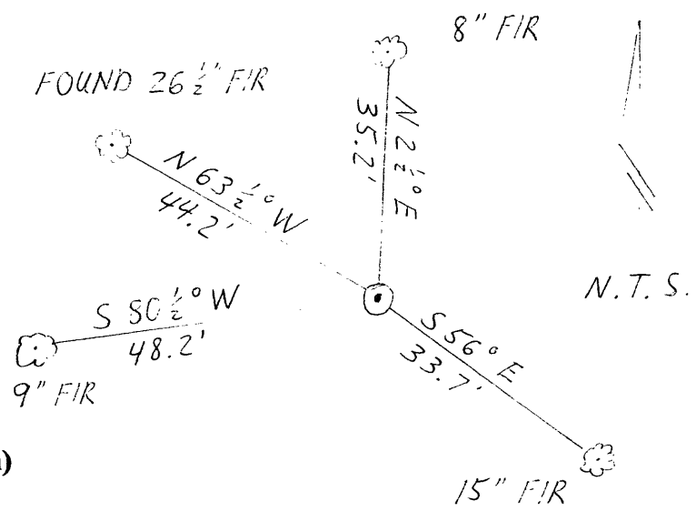

Monument Set (Procedures and Description)

N/A

New Accessories

8" Fir bears N2 1/2*E 35.2' scribed "1/4 S14 BT"
15" Fir bears S56*E 33.7' scribed "1/4 S14 BT"
9" Fir bears S80 1/2*W 48.2' scribed "1/4 S15 BT"
NOTE: We set spikes in the base of all bearing trees; bearings to the trees were measured with a total station & are based on the original GLO survey.

Location & Comments

Corner is located on top of ridge.

Compass Declination: N/A

Firm/Agency:

Gregory D. Lang, Surveyor

Address: 7550 Willis Cr. Rd.

Winston, Oregon 97496

Party Chief: Gregory Lang

Notes: Same

Witness: Trevor Lang

Surveyor's Seal

REGISTERED PROFESSIONAL LAND SURVEYOR

Gregory D. Lang

OREGON JULY 16, 1987 GREGORY D. LANG #2295

12-31-2004

C.S. File No 65/52-11