

**REWITNESSED CORNER FOR
STATE OF OREGON – DEPARTMENT OF FORESTRY**

One quarter corner common to Sections 19 and 24, Township 23 South, Range 9 and 10 West, W.M., Douglas County, Oregon.

ORIGINAL by William H. Byars, 1878

No original evidence found.

REESTABLISHMENT by Lloyd D. Smith, 1981

Oregon State Board of Forestry 1 ½" galvanized iron pipe with 3" bronze cap (in place) from which a:

- 20" Hemlock N46°W 21.2 ft.; now 23" in place, face closed, BLM bearing tree tag.
- 24" Hemlock S10°E 25.4 ft.; now 29" in place, face closed, BLM bearing tree tag and yellow metal location poster.
- 4" x 4" x 72" White Painted Cedar Post N57°E 1.8 ft.; missing
- 5/8" x 30" iron rod N80°10'58"W 23.71ft. ; in place

REWITNESSED from the above pipe and cap:

- Carsonite witness post S46°E 3.40 ft. to base.
- Carsonite witness post S58°W 3.25 ft. to base.

Magnetic variation set at 19° East.

Dated July 6, 2005

Rewitnessed by Tim VanVleet under my direction.
Tim VanVleet

FILED

Date: 7-28-2005 By: JC

This survey consists of:

Map: _____

Narrative: _____


Corner Rpt: 65/54-28

**DOUGLAS COUNTY
SURVEYOR**

Rewitnessed By:



James M. McIntosh

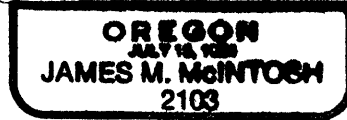

James M. McIntosh
63612 Fifth Road
Coos Bay, Oregon

Expiration date of certificate 12-31-06

Present and witnessed by Ralph C. Hall

C.S. File No 65/54-28