

FILED

Date: 3-17-2006 By: X

This survey consists of:

Map: _____

Narrative: _____

Corner Rpt: 65/58-3

CORNER REPORT FORM

**SE 1/16 Section 10
T.31S., R.6W., W.M.
Douglas County, Oregon**

**DOUGLAS COUNTY
SURVEYOR**

- ___ Condition Report only
- ___ Not Found
- Renewed
- ___ Unrecorded
- ___ Surveyed In
- ___ Referenced out

Previous Renewals/Surveys, etc:

Monumented under M 146-11 in August, 2004

Monument(s) & Accessories Found: (Condition and Source)

A 5/8" iron rod by K. DeGroot in 2004 per M 146-11, firmly set 3" below the surface of a rock road with a 2" diameter aluminum cap stamped:

T31S R6W
SE 1/16 S10
2004
PLS 1941

From which a bearing tree by DeGroot in 2004:

A 7" D.fir bears S.88°15'W., 22.4 feet with scribe marks "SE 1/16 S10 BT" visible on a partially healed blaze.

New Accessories:

A 14" D.fir bears S.33°30'W., 45.7 feet scribed "SE 1/16 S10 BT".

Location & Comments:

All new bearing trees have double blazed faces with a brass washer stamped "PLS 1941" nailed into the lower blazed face. Bearings are measured to the center of the tree at the root crown and distances are measured to a nail in the root crown at the side and center of the tree. All bearing trees have a 6" red band painted around the tree and the blazed faces painted red and bearing tree signs nailed to the tree.

Firm/Agency:


BTS Engineering & Surveying, Inc.
431 SE Main
Roseburg, OR 97470

Party Chief:

This corner renewal was performed by Lester L. Fanning, PLS 2664 on March 13, 2006.

Surveyor's Seal:

REGISTERED
PROFESSIONAL
LAND SURVEYOR

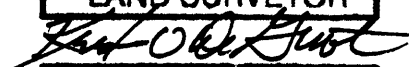

OREGON
JULY 17, 1981
KRISTIAN O. DeGROOT
#1941

RENEWAL 12/31/07

C.S. File No 65/58-3