FILED
Date: 2/19/2008 By: JC
This survey consists of:
Map:
Narrative
Corner Rpt. 65/63-11

DOUGLAS COUNTY
SURVEYOR

CORNER REPORT FORM
Section 14 Township 29S Range 8W
Douglas County Date 2-08
CORNER DESIGNATION

500 440 1/4 COR 515/514

Condition Report only
Not Found
Renewed
~~Unrecorded~~
Surveyed In
Referenced on

Previous Renewals/Surveys, etc:

DCSO 1958
BLM 1976 - 1982

Monument(s) & Accessories Found: (Condition and Source)

FD DCSO BRASS CAP

17" FIR N74E 10.9 FT (Rotten Slag)
30" FIR N63W 10.2 FT Good Scar
38" FIR S74W 24 FT " "

Monument Detail Sketch

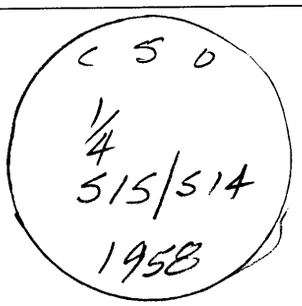

Monument Set (Procedures and Description)

New Accessories

A 7" FIR S37E 5.2 FT
11" FIR N36E 18.7 FT
Both Trees Scribed 1/4 SBT

Location & Comments

Surveyor's Seal

REGISTERED
PROFESSIONAL
LAND SURVEYOR

OREGON
JULY 14, 1978
RONALD A. QUIMBY
1654

EXP 12-31-08

Compass Declination
Firm/Agency: i.e. Engineering, Inc.
Address: 505 SE Main
Roseburg, OR 97470
Party Chief: M. Fromdahl
Notes:
Witness:
C.S. File No 65/63-11