FILED
Date: 7/30/08 By: JC
This survey consists of:
Map: ____
Narrative: ____
Corner Rpt: 65/63-24
DOUGLAS COUNTY
SURVEYOR

OREGON CORNER RESTORATION FORM

Section 22 Township 21 South, Range 7 West
County Douglas Date 22 July 2008

Corner Description

1/4 Corner
of sections 21 and 22

___ Condition Report Only
___ Not Found
_X_ Renewed
___ Unrecorded
___ Surveyed In
___ Referenced Out

Previous Renewals / Surveys, etc.

Monument (s) & Accessories Found: (Condition and Source)
Found 2-1/2" brass cap dated 1959 with the following accessories:
27" Hemlock bears S82-1/2°E 29.0' – healed face

Monument Detail

Monument Set (Procedures and Description)
None

Sketch

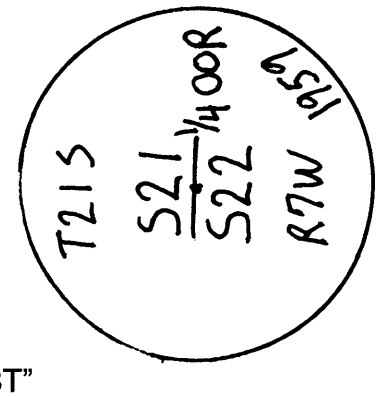

New Accessories
34" D. fir bears N84°W 30.8' – blazed, scribed "1/4 S21 BT"
22" D. fir bears S46°W 40.6' – blazed, scribed "1/4 S21 BT"
14" Maple bears N27°E 10.6" – blazed, scribed "1/4 S22 BT"

Location & Comments

Corner has steel post adjacent to it. All BT's have red painted bands and yellow tags.

Compass Declination 17° East
Firm/Agency Ward NorthWest Inc.
Address P.O. Box 105
Florence, OR 97439
Party Chief Ron Rice
Notes
Witness Josh Reed

Surveyor's Seal

REGISTERED
PROFESSIONAL
LAND SURVEYOR
Ronald L. Rice
OREGON
JULY 9, 2002
RONALD L. RICE
#54633 LS
Expires: 12-31-08

C.S. File No 65/63-24